

KANSAS


Barton County

FORM 51 5M PETROL

Section 2 Township 16 Range 12W

Well No. 1 Weber

Company Woodriver Oil

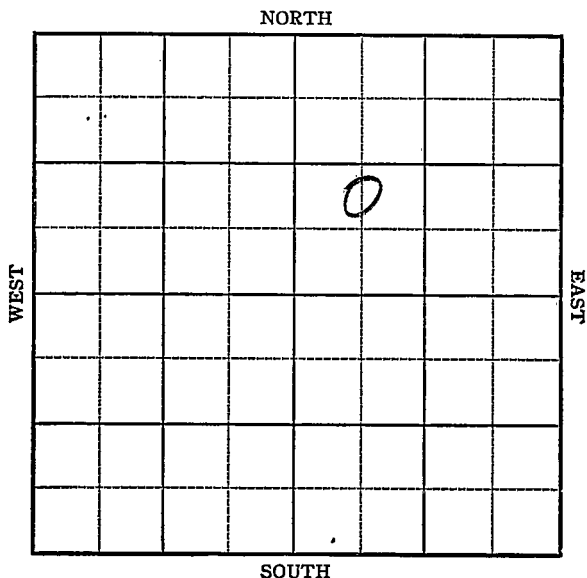

KANSAS

Barton

Sec. 2 Twp. 16 R. 12W

Well No. 1 Weber Farm

~~Fred Koch~~ Woodriver Oil Company

Kraft-Prusa


 Ft. from N. Line

990 Ft. from S. Line

 Ft. from E. Line

660 Ft. from W. Line

C N L SW NE

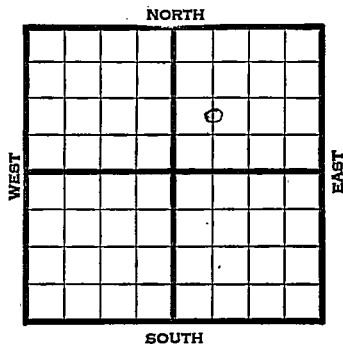

1945

REPORT

Elev. 1881

5/29

RUR

6/8

8" @ 192

6/27

Cong. 3336


TD 3346'

ABANDONED

Kansas Pool Name Kraft-PrusaMap No. 55 Sec. 2 Twp. 16 R. 12WWell No. 1 WeberFred Koch CompanyFIRST REPORT Contractor

C N L SW NE

SECTION PLAT

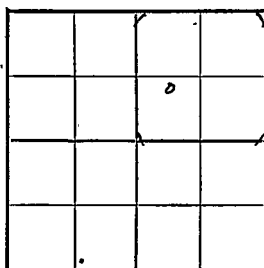 Ft. from N. Line990 Ft. from S. Line Ft. from E. Line660 Ft. from W. LineBarton CountyLocation Rig up

Drilling and Remarks:

RUR

RECORD

Cased in., ft.Sand Gas Oil Total Depth

PRODUCTION

1st 24 hrs. Nat. 1st 24 hrs. after shot Gas Cu. Ft.✓ Dry Hole Abandoned

Date

MAY 29 1945

19

S. J. LEWIS

Scout

Kansas Pool Name Kraft-PrusaMap No. 55 Sec. 2 Twp. 16 R. 12WWell No. 1 WeberWoodriver Oil CompanyCORRECTION Contractor

C N L SW NE

SECTION FLAT

		o	

 Ft. from N. Line990 Ft. from S. Line Ft. from E. Line660 Ft. from W. LineBarton CountyLocation Rig up

Drilling and Remarks:

reported as
Fred Koch

RECORD

Cased in., ft.Sand Gas Oil Total Depth

PRODUCTION

1st 24 hrs. Nat. 1st 24 hrs. after shot Gas Cu. Ft.Dry Hole Abandoned

Date

JUN 6 1945

19

S. J. LEWIS Scout

Kansas Pool Name Kraft-PrusaMap No. 55 Sec. 2 Twp. 16 R. 12WWell No. 1 WeberWoodriver Oil

Company

ABANDONED

Contractor

C N L SW NE

E 1/89/
SECTION PLAT Ft. from N. Line990 Ft. from S. Line Ft. from E. Line660 Ft. from W. Line

		o	

Barton CountyLocation Rig up

Drilling and Remarks:

Cong 3336**RECORD**Cased in., ft.Sand Gas Oil Total Depth 3346**PRODUCTION**1st 24 hrs. Nat. 1st 24 hrs. after shot Gas Cu. Ft.Dry Hole Abandoned

Date

JUN 27 1945 19S. J. LEWIS Scout