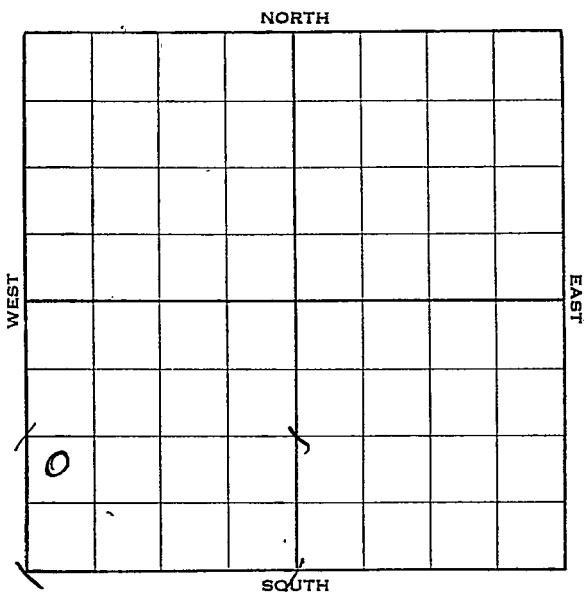



KANSAS

Barton

Section 3 Township 16 Range 12-WWell No. #1 MillerCompany Tomp Palmer

KANSAS

Barton

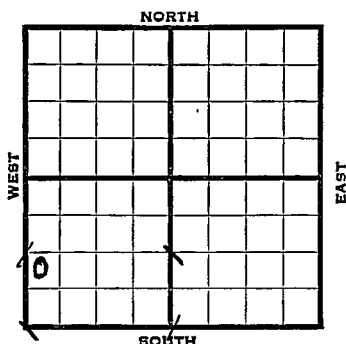Sec. 3 Twp. 16 R. 12-WWell No. #1 Miller FarmTom Palmer Company Ft. from N. Line990 Ft. from S. Line Ft. from E. Line330 Ft. from W. Line

Elev. 1845'.

1938	REPORT
11/9	Cellar.
11/18	R U R
11/25	10" - 205'. Dlg. 1205'.
12/2	Drlg. 2710'.
12/9	Lans. 3035'. S. O. 3191-3200'.
	Gorham 3223'. T. D. 3224'.
	Running 7".
12/15	Gorham 3323-24' (Corrected)
	7" - 3322'. S. W. 3330-31'.
12/21	7" - 3322'.
	Gorham 3323'.
	T. D. 3356'.
	P. B. 3205'.
	50 shots 3178-85' S. S. O.
	2500 acid.
	No help.
	ABANDONED

Map No. 55 Sec. 3 Twp. 16 R. 12WWell No. 1 MillerTom Palmer

Company

Contractor

FIRST REPORT

NW SW SW

Ft. from N. Line

990 Ft. from S. Line

Ft. from E. Line

330 Ft. from W. Line

SECTION PLAT

Location

Rig up

Drilling and Remarks:

Cellar

RECORD

Cased _____ in., _____ ft.

Sand _____

Gas _____

Oil _____

Total Depth _____

PRODUCTION

1st 24 hrs. Nat. _____

1st 24 hrs. after shot _____

Gas _____ Cu. Ft.

Dry Hole _____

Abandoned _____

Date

NOV 9 - 1938

R. Hatfield

19

Scout

Barton

Map No. 55 Sec. 3 Twp. 16 R. 12WWell No. 1 MillerTom Palmer

Company

Contractor

ABANDONED

NW SW SW

SECTION PLAT

0			

 Ft. from N. Line990 Ft. from S. Line Ft. from E. Line330 Ft. from W. Line

BEAVER NORTH POOL

Location Rig up

Drilling and Remarks:

P.B. 3205
 50 shots 3178-85
 S.S.O.
 2500 Acid
 No help
 D & A.

RECORD

Cased 7 in., 3322 ft.Sand Gorham 3323Gas Oil Total Depth 3356

PRODUCTION

1st 24 hrs. Nat. 1st 24 hrs. after shot Gas Cu. Ft.Dry Hole Abandoned

Date

DEC 21 1938

19

H. D. Hatfield

Scout