KANSAS


Barton

FORM 51 5M PETROL

Section 3 Township 16 Range 12-W

Well No. #1 Polzin

Company Winkler-Kock

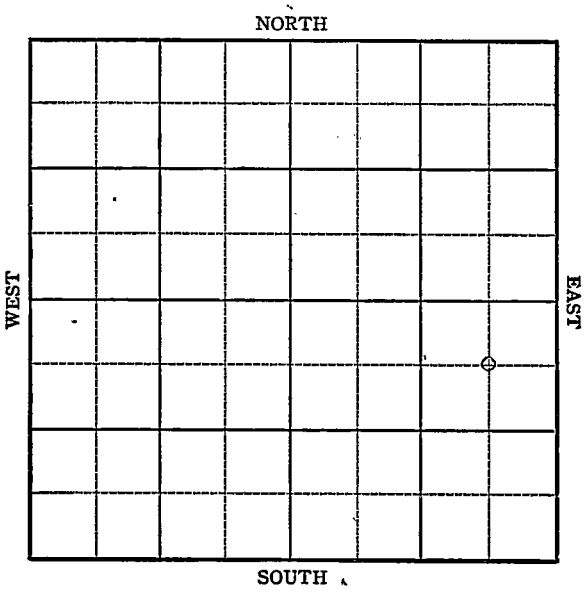

FORM 252-A
5M 9-43 GASS KANSAS Barton

Sec. 3 Twp. 16 R. 12 W

Well No. #1 Polzin Farm


Winkler-Kock Company

660 Ft. from N. Line

Ft. from S. Line

660 Ft. from E. Line

Ft. from W. Line

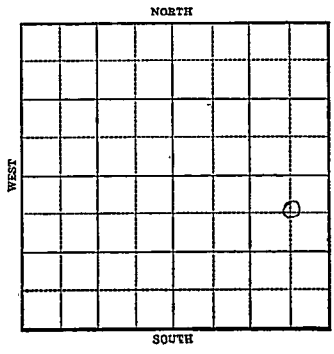

Elev. 1890

1943	REPORT
12-8	Location
12-15	"
12/22	8" @ 295 Drlg. 2250
12/29	Drlg. 3185'
1944	
1-5	Lans 3077 3320 fsg
1-12	"
1/19	"
1/26	Whipstock 3111 WOC
2/2	Cong 3349 Arb 3355 TD 3380 ABANDONED

Form 26 200 Bks 5-42 Petrol Barton

KANSAS

Map No. J J Sec. 3 Twp. 16 R. 12W

Well No. 1 Polzin

Winkler-Kock Company

FIRST REPORT Contractor

C NE SE


660 Ft. from N. Line

____ Ft. from S. Line

660 Ft. from E. Line

____ Ft. from W. Line

SECTION PLAT

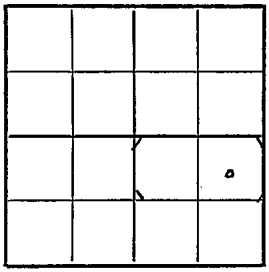

Beaver Pool

Location X

Rig up

Drilling and Remarks:

RECORD

Cased ____ in., ____ ft.

Sand

Gas

Oil

Total Depth

PRODUCTION

1st 24 hrs. Nat.

1st 24 hrs. after shot

Gas ____ Cu. Ft.

Dry Hole

Abandoned

Date

DEC 8 1943 19 S. J. LEWIS Scout

Form 26 200 Bks 5-42 Petrol

Barton

KANSAS

Map No. 33 Sec. 3 Twp. 16 R. 12W


Well No. 1 Polzin

Winkler-Kock Company

ABANDONED Contractor

C NE SE

SECTION PLAT

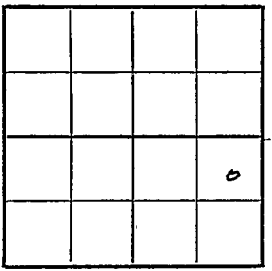

660 Ft. from N. Line

Ft. from S. Line

660 Ft. from E. Line

Ft. from W. Line

Beaver Pool

Location

Rig up

Drilling and Remarks:

Comp 3349

ELY 3305

RECORD

Cased in., ft.

Sand

Gas

Oil

Total Depth 3380

PRODUCTION

1st 24 hrs. Nat.

1st 24 hrs. after shot

Gas Cu. Ft.

Dry Hole

Abandoned

Date

FEB 2 1944 19

S. J. LEWIS Scout