


Woodson

KANSAS ✓

Section 29 Township 25 Range 14-E

Well No. 1 - Corkery

Company Sheedy

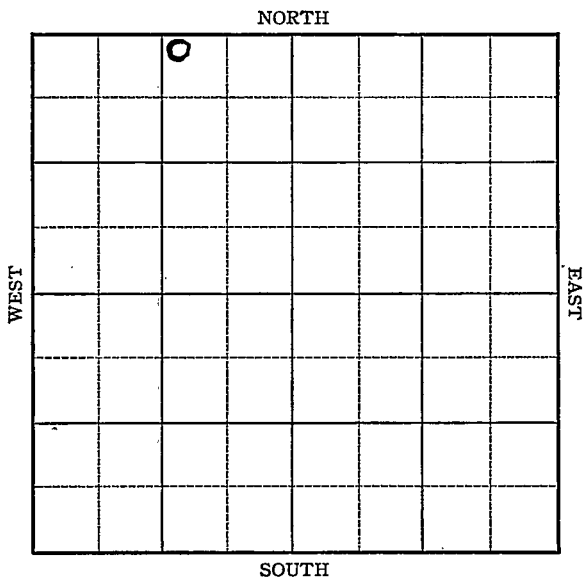

Sec. 29 Twp. 25 R. 14-E


Well No. #1 Corkery Farm
Sheedy Company

175 Ft. from N. Line

_____ Ft. from S. Line

1154 Ft. from E. Line

_____ Ft. from W. Line

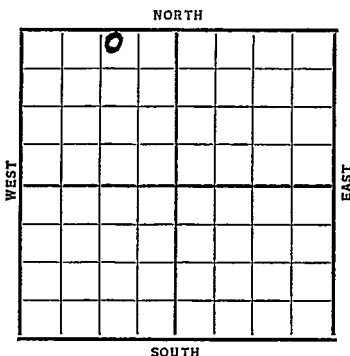

Date	REPORT
1937	
9/8	Spud.
9/24	Drlg. 1195'.
10/2	" "
10/8	10" @ 620'. 8" @ 1100'.
	6" @ 1382'. Bart 1382-1405'
	T.D. 1405'. Good show oil &
	gas. Shot 220 qts. Fsg. Bailer
10/15	T.D. 1420' C.O.
10/20	6" @ 1382'.
	Bart. 1382'.
	T.D. 1420'.
	Shot 220 qts.
	Potential 45 bbls.
	COMPLETED

KANSAS

Map No. 17 Sec. 29 Twp. 25 R. 14E

Well No. 1 - Corkery

Shedy Company

Contractor

FIRST REPORT

SECTION PLAT

175 Ft. from N. Line

_____ Ft. from S. Line

1154 Ft. from E. Line

_____ Ft. from W. Line

	9		

Location _____

Rig up _____

Drilling and Remarks:

Spud

RECORD.

Cased _____ in., _____ ft.

Sand _____

Gas _____

Oil _____

Total Depth _____

PRODUCTION

1st 24 hrs. Nat. _____

1st 24 hrs. after shot _____

Gas _____ Cu. Ft.

Dry Hole _____

Abandoned _____

Date

SEP 8 1937

19

H. D. Hatfield

Scout

Woods on

KANSAS

Map No. 17 Sec. 29 Twp. 25 R. 14EWell No. 1 CorkerySheedy

Company

Contractor

COMPLETED

NW NE NW

175 Ft. from N. Line

_____ Ft. from S. Line

1154 Ft. from E. Line

_____ Ft. from W. Line

SECTION PLAT

	0		

Location _____

Rig up _____

Drilling and Remarks:

*shot 220 gts**Pat-45*

RECORD

Cased 6 in., 1382 ft.Sand Bart 1382

Gas _____

Oil _____

Total Depth 1420

PRODUCTION

1st 24 hrs. Nat. _____

1st 24 hrs. after shot _____

Gas _____ Cu. Ft.

Dry Hole _____

Abandoned _____

Date

NOV 20 1937 19H. D. Hatfield

Scout