


Section 27 Township 25 Range 14-E

Well Number 1 Fuhlhage

Company Sheedy et al

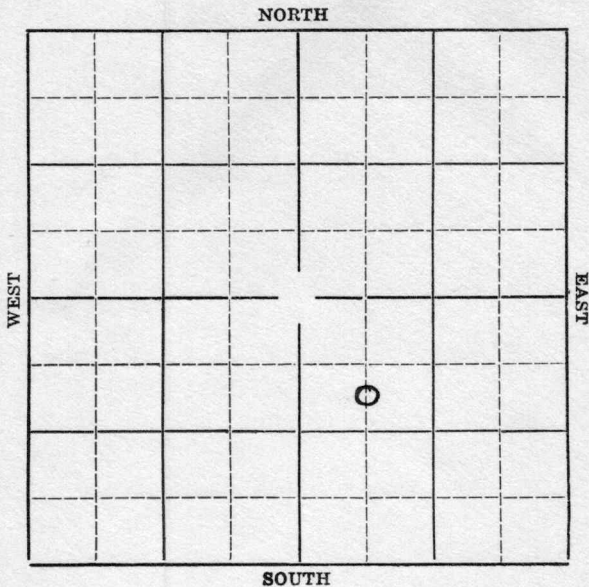

Sec. 27 Twp. 25 R. 14-E

Well No. #1 Fhhlhage Farm


Sheedy et al Company

990 Ft. from N. Line

Ft. from S. Line

Ft. from E. Line

660 Ft. from W. Line

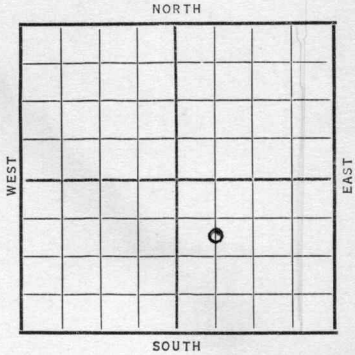

Date 1937

REPORT

2/24 Mech.

3/4 12" @ 160 Drlg. 775'.

3/17 Mississippi Lime 1549'.

T. D. 1568'.

~~ABANDONED~~ ~~ABANDONED~~ ~~ABANDONED~~

Map No. 17 Sec. 27 Twp. 25 R. 14E

Well No. 1 Furbhage

Sheedy & Dal Company

Contractor

### SECTION PLAT

		o	

990 Ft. from N. Line

\_\_\_\_\_ Ft. from S. Line

\_\_\_\_\_ Ft. from E. Line

660 Ft. from W. Line

### FIRST REPORT

Location \_\_\_\_\_

Rig up \_\_\_\_\_

Drilling and Remarks:

*Mach*

### RECORD

Cased \_\_\_\_\_ in., \_\_\_\_\_ ft.

Sand \_\_\_\_\_

Gas \_\_\_\_\_

Oil \_\_\_\_\_

Total Depth \_\_\_\_\_

### PRODUCTION

1st 24 hrs. Nat. \_\_\_\_\_

1st 24 hrs. after shot \_\_\_\_\_

Gas \_\_\_\_\_ Cu. Ft.

Dry Hole \_\_\_\_\_

Abandoned \_\_\_\_\_

Date

FEB 24 1937

19

S. J. LEWIS

Scout

Map No. 17 Sec. 27 Twp. 25 R. 14E

Well No. 1 Fullpage

Sheedy Company  
Contractor

SECTION PLAT

		0	

990 Ft. from N. Line

\_\_\_\_\_ Ft. from S. Line

\_\_\_\_\_ Ft. from E. Line

660 Ft. from W. Line

ABANDONED

Location \_\_\_\_\_

Rig up \_\_\_\_\_

Drilling and Remarks:

*Mississippi limestone*  
1549

RECORD

Cased \_\_\_\_\_ in., \_\_\_\_\_ ft.

Sand \_\_\_\_\_

Gas \_\_\_\_\_

Oil \_\_\_\_\_

Total Depth 1568

PRODUCTION

1st 24 hrs. Nat. \_\_\_\_\_

1st 24 hrs. after shot \_\_\_\_\_

Gas \_\_\_\_\_ Cu. Ft.

Dry Hole

Abandoned

Date

MAR 17 1937 19

S. J. LEWIS Scout