

Woodson

KANSAS

FORM 51 25M 3-49 PETROL

Section 27 Township 25 Range 1/E

Well No. #1 Fuhlhage

Company R. Bringer

Miscellaneous

NORTH

WEST

EAST

							0

SOUTH

Sec. 27 Twp. 25 R. 14E ✓

Well No. #1 Fuhlhage Farm
R. Bringer

Miscellaneous (Brownlee & Alcock, Contr.) Company


320' Ft. from N. Line

_____ Ft. from S. Line

500' Ft. from E. Line

_____ Ft. from W. Line

NE SE

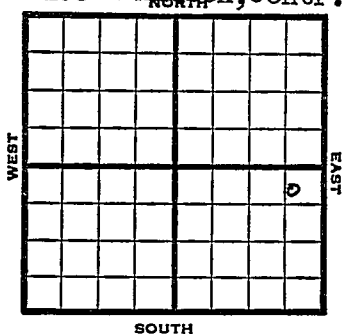

1949 Elev 1061' REPORT

11/30 10" @ 169'
Drlg. 460'
12/7 Bart 1435'
6" @ 1435'
12/14 TD 1491'
12/21 "
12/28 "
1950
1/11 TD 1491'
10" @ 169'
6" @ 1435'
Plug back to 1473'
shot with 20 qts
PP 50 BOPD
Bartsville 1461'
Comp

COMPLETED

Map No. _____ Sec. 27 Twp. 25 R. 14EWell No. 1 FuhlhageR. Bringar CompanyBrownlee & Alcock Contractor

NE SE

FIRST REPORT
SECTION PLAT320 Ft. from N. Line

_____ Ft. from S. Line

500 Ft. from E. Line

_____ Ft. from W. Line

Woodson County

Location _____

Rig up _____

Drilling and Remarks:

10" @ 169

drlg. 460

RECORD

Cased _____ in., _____ ft.

Sand _____

Gas _____

Oil _____

Total Depth _____

PRODUCTION

1st 24 hrs. Nat. _____

1st 24 hrs. after shot _____

Gas _____ Cu. Ft.

Dry Hole _____

Abandoned _____

Date

NOV 30 1949

19

S. J. LEWIS Scout

Map No. _____ Sec. 27 Twp. 25 R. 14EWell No. 1 Fuhlhage_____ R. Bringar _____ Company

Contractor

NE SE

E. W. 1061
SECTION PLAT320 Ft. from N. Line

_____ Ft. from S. Line

500 Ft. from E. Line

_____ Ft. from W. Line

COMPLETE		
		o

Woodson County

Location _____

Rig up _____

Drilling and Remarks:

10" @ 169
6" @ 1435
Plug Back to 1473
shot with
20 gts -
PP 50 B.O.P.D

RECORD

Cased _____ in., _____ ft.

Sand _____

Gas _____

Oil _____

Total Depth 1491

PRODUCTION

1st 24 hrs. Nat. _____

1st 24 hrs. after shot _____

Gas _____ Cu. Ft.

Dry Hole _____

Abandoned _____

Date

JAN 11 1950

19

J. E. TYRA

Scout

Britsville 1461

JAN 16 1950

Scout Cards *Smith*
Land Small Map *3*
Land Wall Map *3*
Tracings
France Map
Pierce Map
Misc.