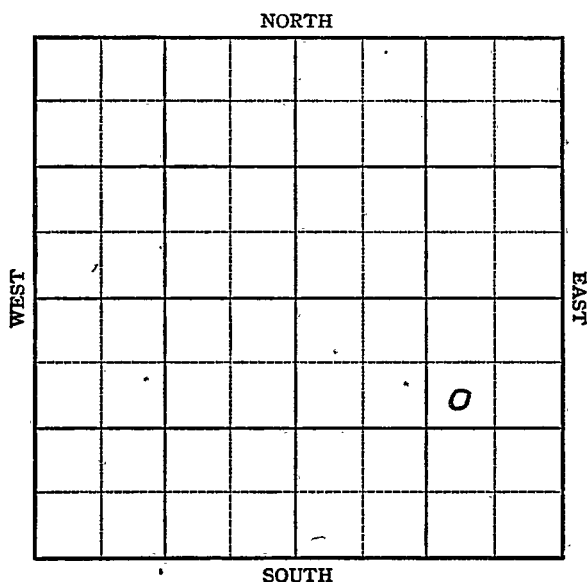


KANSAS

O. W. D. D

Barton county

Section 4 Township 16 Range 12-WWell No. #3, PolzinCompany Palmer Oil Company

KANSAS

O. W. D. D
Barton County

Sec. 4 Twp. 16 R. 12-W

Well No. 3 Polzin Farm

Palmer Oil Company

Kraft-Prusa


990 Ft. from N. Line

 Ft. from S. Line

990 Ft. from E. Line

 Ft. from W. Line

SW NE SE

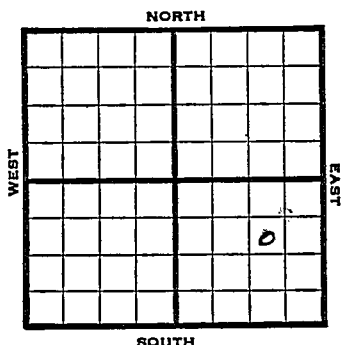

1947

Elev. 3306 REPORT

1/15 8" @ 157'
drlg. 2230'

1/21 TD 3306'
5" @ 3303
RUST

2/5 TD 3306
Arb 3300
5" @ 3303
Pump 50 Pot
Grav. 42

COMPLETED
O. W. D. D

1951
10/10 Arb. 3300' OTD 3306' 5" @ 3303'
Was Arb. Prod.
DD Regan 3355' Schist 3410-51' TD
1000 A
SWD - Complete

FIRST REPORT
✓
ABANDONED

Map No. 55 Sec. 4 Twp. 16 R. 12WWell No. 3 PolzinPalmer Oil

Company

FIRST REPORT

Contractor

SW NE SE

SECTION PLAT

990 Ft. from N. Line Ft. from S. Line990 Ft. from E. Line Ft. from W. Line

			o

Barton County

Location Rig up

Drilling and Remarks:

8" @ 157

drlg. 2230

RECORD

Cased in., ft.Sand Gas Oil Total Depth

PRODUCTION

1st 24 hrs. Nat. 1st 24 hrs. after shot Gas Cu. Ft.Dry Hole Abandoned

Date

JAN 15 1947

19

S. J. LEWIS

Scout

Form 26 200 Bks. 10-46 Petrol
Kansas

Kraft-Prusa Pool

Map No. 55 Sec. 4 Twp. 16 R. 12W

Well No. 3 Polzin

Palmer Oil Company

COMPLETE

Contractor

SW NE SE


E1/847
SECTION PLAT

990 Ft. from N. Line

 Ft. from S. Line

990 Ft. from E. Line

 Ft. from W. Line

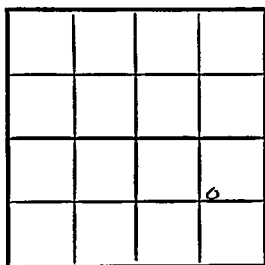

Barton County

Location

Rig up

Drilling and Remarks:

Cor 3300

5" 3303

Pump 50 ft

42 9/16

RECORD

Cased in., ft.

Sand

Gas

Oil

Total Depth 3306

PRODUCTION

1st 24 hrs. Nat.

1st 24 hrs. after shot

Gas Cu. Ft.

Dry Hole

Abandoned

Date

FEB 5 1947

19

S. J. LEWIS

Scout

County Barton State KansasSec. 4 (Blk.) 16 (Sur.) 12W Map No.Operator Tom PlamerWell No. 3 Farm PolzinElev. Location SW/SE NE SE990 Ft. From N Line SE990
530 Ft. From E Line QuarterIst. Report OCT 10 1951

Completion

Remarks

OWDD

O. W. D. D

Spudding Date

Drlg. Data FitesArb 3300 OTD 3306 5" @ 3303 was arb. prod.DD Regan 3355 Schist 3410-51 T.D. 1000ASwd. Complete.