


Section 4 Township 16 Range 12W
Well No. #1 W. M. Polzin
Company Wakefield & Bennett

NORTH

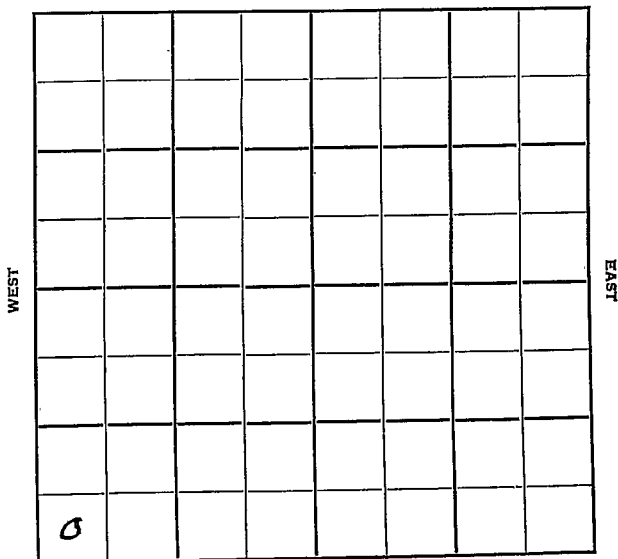

SOUTH

KANSAS

Barton

Sec. 4 Twp. 16 R. 12-W

Well No. #1 W M Polzin Farm

Wakefield & Bennett Company

Beaver Pool Contractor


Ft. from N. Line

330 Ft. from S. Line

Ft. from E. Line

330 Ft. from W. Line

SW SW SW

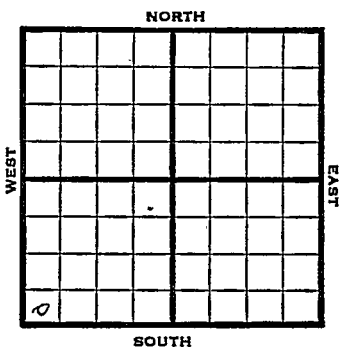

1950

Elev 1878' REPORT

2/1

Cellar & Pits.

4/12

TD 3367'

12"@ 480'

10"@ 812'

8"@ 2112'

KC 3050'

Cong 3337'

D&A

Aband.

ABANDONED

Kansas


Beaver Pool

Map No. _____ Sec. 4 Twp. 16 R. 12WWell No. 1 W. M. PolzinWakefield & Bennett Company_____
Contractor

SW SW SW

El. 1878

SECTION PLAT

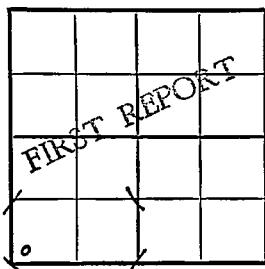Ft. from N. Line330 Ft. from S. Line_____
Ft. from E. Line330 Ft. from W. Line

Barton County

Location _____

Rig up _____

Drilling and Remarks:

Cellar & pits

RECORD

Cased _____ in., _____ ft.

Sand _____

Gas _____

Oil _____

Total Depth _____

PRODUCTION

1st 24 hrs. Nat. _____

1st 24 hrs. after shot _____

Gas _____ Cu. Ft.

Dry Hole _____

Abandoned _____

Date

FEB 1 1950

19


J. E. TYRA Scout

Kansas

Beaver Pool

Map No. _____ Sec. 4 Twp. 16 R. 12WWell No. 1 W. M. PolzinWakefield & Bennett Company_____
Contractor

SW SWSW

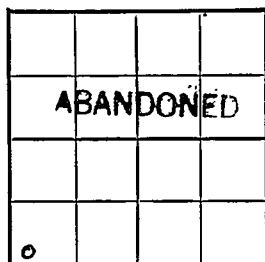E/ 1878
SECTION PLAT_____
Ft. from N. Line330 Ft. from S. Line_____
Ft. from E. Line330 Ft. from W. LineBarton County

Location _____

Rig up _____

Drilling and Remarks:

12" @ 480
10" @ 812
8" @ 2112
K.C. 3050
Log 3337
D & A

RECORD

Cased _____ in., _____ ft.

Sand _____

Gas _____

Oil _____

Total Depth 3367

PRODUCTION

1st 24 hrs. Nat. _____

1st 24 hrs. after shot _____

Gas _____ Cu. Ft.

Dry Hole _____

Abandoned _____

Date

APR 12 195019J. E. TYRAScout