




Section 27 Township 25 Range 14E

Well No. 1 Fuhsage

Company Newcomer & Brinegar

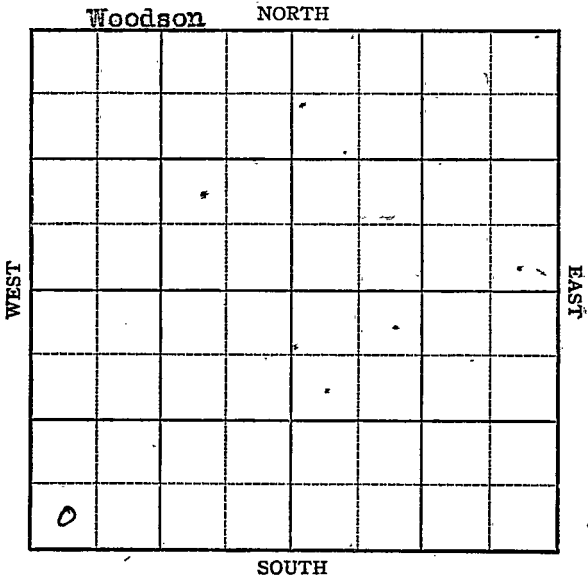

KANSAS

Woods on

Sec. 27 Twp. 25 R. 14-E

Well No. 1 Fuhlsage Farm

Newcomer & Brinegar Company

Miscellaneous


_____ Ft. from N. Line

330 Ft. from S. Line

_____ Ft. from E. Line

330 Ft. from W. Line

SW/C

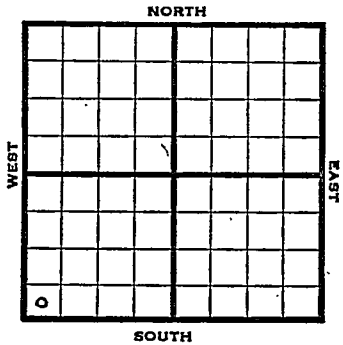

1947

REPORT

9/3
 KC 590'
 6" @ 590
 Bart. 1475'
 TD 1486'
 40 qts 1475-81
 PB 627
 500 acid

9/10
 Bart. 1475'
 TD 1486'

ABANDONED

Map No. _____ Sec. 27 _____ 25 _____ R. 14E

Well No. 1 Fuhlsage _____

Newcomer & Brinegar _____ Company

FIRST REPORT _____ Contractor

SW/C

SECTION PLAT

_____ Ft. from N. Line

330 _____ Ft. from S. Line

_____ Ft. from E. Line

330 _____ Ft. from W. Line

Woodson County

Location _____

Rig up _____

Drilling and Remarks:

KC 590
 6" @ 590
 Bart. 1475
 TD 1486
 40 qts. 1475-81
 PB 627
 500 acid

RECORD

Cased _____ in. _____ ft.
 Sand _____
 Gas _____
 Oil _____
 Total Depth _____

PRODUCTION

1st 24 hrs. Nat. _____
 1st 24 hrs. after shot _____
 Gas _____ Cu. Ft.
 Dry Hole _____
 Abandoned _____

Date

SEP 3 1947 19

S. J. LEWIS Scout

Map No. 17 Sec. 27 Twp. 25 R. 14E

Well No. 1 Fuhlsage

Newcomer & Brinegar Company

ABANDONED Contractor

SW/C

SECTION PLAT

_____ Ft. from N. Line

330 Ft. from S. Line

_____ Ft. from E. Line

330 Ft. from W. Line

Woodson County

Location _____

Rig up _____

Drilling and Remarks:

See Y1475

RECORD

Cased _____ in. _____ ft.

Sand _____

Gas _____

Oil _____

Total Depth 1486

PRODUCTION

1st 24 hrs. Nat. _____

1st 24 hrs. after shot _____

Gas _____ Cu. Ft.

Dry Hole _____

Abandoned _____

Date

SEP 10 1947 19

S. J. LEWIS Scout