

Woodson

KANSAS


FORM 51 25M 3-49 PETROL

Section 27 Township 25 Range 14E

Well No. #3 Fuhlhage

Company R. L. Brinegar

NORTH

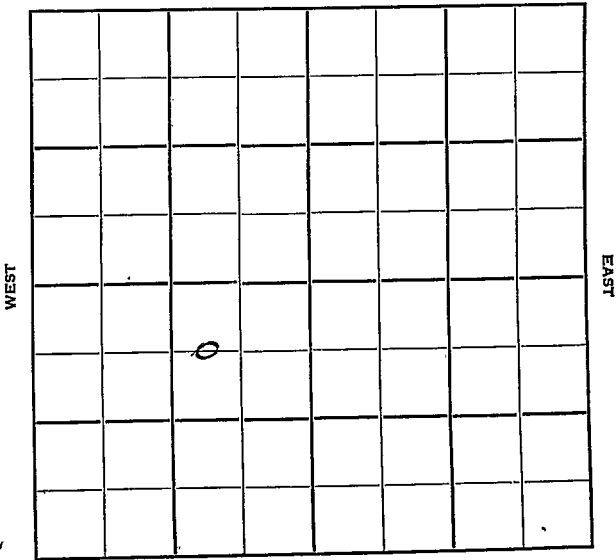

SOUTH

Sec. 27 Twp. 25 R. 14E ✓

Well No. #3 Fuhlhage Farm

R. L. Brinegar Company

Contractor

Miscellaneous


660' Ft. from N. Line

Ft. from S. Line

990' Ft. from E. Line

Ft. from W. Line

C W L NE SW

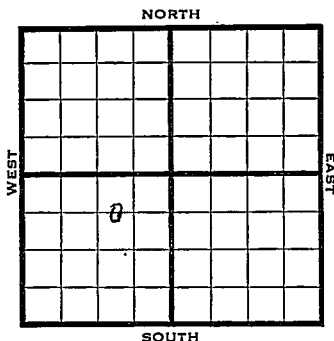

1950

REPORT

2/8 Spud 2-2-50
Drlg. 100'

3/15 TD 1495'
10" @ 168'
7" @ 1432'
Bart 1463'
Sand 1495'
Flow 80 BOPD
Comp

COMPLETED

Kansas

Map No. _____ Sec. 27 Twp. 25 R. 14E

Well No. 3 Fuhlhage

R. L. Brinegar

Company

Contractor

C W L NE SW

SECTION PLAT


660 Ft. from N. Line

_____ Ft. from S. Line

990 Ft. from E. Line

_____ Ft. from W. Line

Woodson County

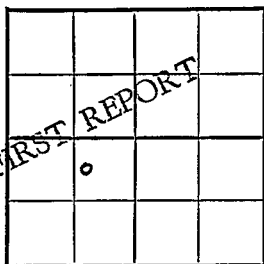

Location _____

Rig up _____

Drilling and Remarks:

Spud 2-2-50

drlg. 100

RECORD

Cased _____ in., _____ ft.

Sand _____

Gas _____

Oil _____

Total Depth _____

PRODUCTION

1st 24 hrs. Nat. _____

1st 24 hrs. after shot _____

Gas _____ Cu. Ft.

Dry Hole _____

Abandoned _____

Date

FEB 8 1950 19

J. E. TYRA

Scout

Kansas

Map No. _____ Sec. 27 Twp. 25 R. 14EWell No. 3 FuhlhageR. L. Brinegar

Company

Contractor

C W L NE SW

660

Ft. from N. Line

Ft. from S. Line

990

Ft. from E. Line

Ft. from W. Line

Woodson County

SECTION PLAT

		COMPLETE	
	o		

Location _____

Rig up _____

Drilling and Remarks:

10" @ 1687" @ 1432Bant 1463Sand 1495Flow 80 BOPD

RECORD

Cased _____ in., _____ ft.

Sand _____

Gas _____

Oil _____

Total Depth 1495

PRODUCTION

1st 24 hrs. Nat. _____

1st 24 hrs. after shot _____

Gas _____ Cu. Ft.

Dry Hole _____

Abandoned _____

Date

MAR 15 1950

19

J. E. TYRAScout