


Woodson

KANSASSection 27 Township 25 Range 14E ✓Well No. #4 FuhlhageCompany R. L. Brinegar

NORTH

WEST

EAST

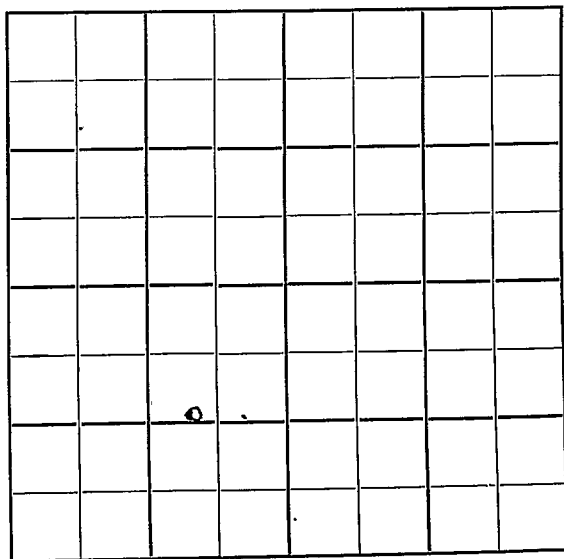

SOUTH

Sec. _____ Twp. _____ R. _____

Well No. #4 Fuhlage Farm

R. L. Brinegar Company

Contractor

Miscellaneous


1250' Ft. from N. Line

Ft. from S. Line

800' Ft. from E. Line

Ft. from W. Line

SW NE SW

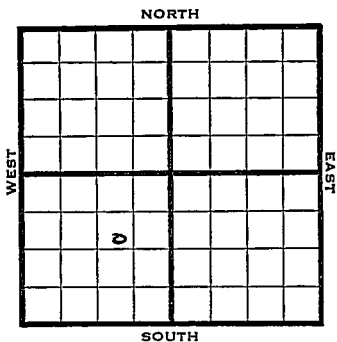

1950

REPORT

3/15

Location

4/26

TD 1490'

8" @ 799'

Bart 1460-90'

D&A

Aband.

ABANDONED


Map No. _____ Sec. 27 Twp. 25 R. 14EWell No. 4 FuhlhageR. L. Brinegar

Company

Contractor

SW NE SW

SECTION PLAT

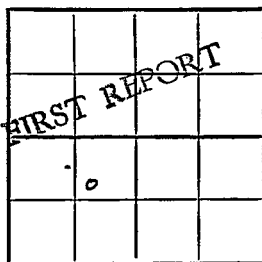1250 Ft. from N. Line Ft. from S. Line800 Ft. from E. Line Ft. from W. LineWoodson CountyLocation X

Rig up _____

Drilling and Remarks:

RECORD

Cased _____ in., _____ ft.

Sand _____

Gas _____

Oil _____

Total Depth _____

* PRODUCTION

1st 24 hrs. Nat. _____

1st 24 hrs. after shot _____

Gas _____ Cu. Ft.

Dry Hole _____

Abandoned _____

Date

MAR 15 1950 19J. E. TYRA Scout

Map No. _____ Sec. 27 Twp. 25 R. 14E

Well No. 4 Fuhlhage

R. L. Brinegar

Company

Contractor

SW NE SW

1250 Ft. from N. Line

Ft. from S. Line

800 Ft. from E. Line

Ft. from W. Line

SECTION PLAT

ABANDONED

0

Woodson County

Location

Rig up

Drilling and Remarks:

8" e 799
Barth. 1460-20

D + A

RECORD

Cased _____ in., _____ ft.

Sand _____

Gas _____

Oil _____

Total Depth 1490

PRODUCTION

1st 24 hrs. Nat. _____

1st 24 hrs. after shot _____

Gas _____ Cu. Ft.

Dry Hole _____

Abandoned _____

Date

APR 26 1950

19

J. E. TYRA

Scout