

KANSAS

FORM 51 25M 3-49 PETROL

Barton

Section 5 Township 16 Range 12W

Well No. 2 Depiesse

Company Phillips & Hanson

Kraft-Prusa

NORTH

WEST

EAST

SOUTH

6

Barton

KANSAS

Sec. 5 Twp. 16 R. 12W ✓

Well No. #2 Depiesse Farm

Phillips & Hanson Company


Kraft-Prusa Pool

 Ft. from N. Line

990' Ft. from S. Line

990' Ft. from E. Line

 Ft. from W. Line

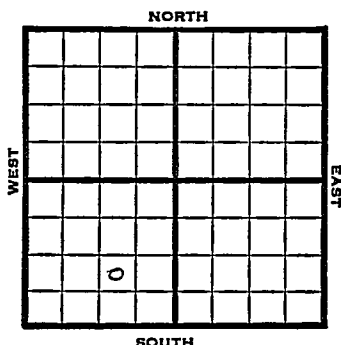

NW SE SW

1949 E lev 1856' REPORT

6/29 8" @ 513'

7/6 Lansing 3026'
Drlg. 3182'

7/12 Arb. 3275-78'
TD 3278'
5"@ 3276'

7/26 Swb 28 bbls oil
PH 12 hrs.

7/27 300 acid

8/3 "

8/10 "

8/17 TD 3278'
Arb. 3275'
5"@ 3276'
300 acid
Echo Pot 3000
42° Gr.

Comp

COMPLETED

Map No. _____ Sec. 5 Twp. 16 R. 12W

Well No. 2 Depiesse

Phillips & Hanson Company

Contractor

NW SE SW

FIRST REPORT
SECTION PLAT

_____ Ft. from N. Line

990 Ft. from S. Line

990 Ft. from E. Line

_____ Ft. from W. Line

Barton County

Location _____

Rig up _____

Drilling and Remarks:

8" @ 513

RECORD

Cased _____ in., _____ ft.

Sand _____

Gas _____

Oil _____

Total Depth _____

PRODUCTION

1st 24 hrs. Nat. _____

1st 24 hrs. after shot _____

Gas _____ Cu. Ft.

Dry Hole _____

Abandoned _____

Date

JUN 29 1949

19

S. J. LEWIS

Scout

Kansas

Map No. 155 Sec. 5 Twp. 16 R. 12WWell No. 2 Deniesse

Phillips & Hanson

Company

COMPLETE

Contractor

SW SE SW

E 11836
SECTION PLAT

	4		

Ft. from N. Line

990 Ft. from S. Line990 Ft. from E. Line

Ft. from W. Line

Barton County

RECORD

Location

Cased _____ in., _____ ft.

Rig up

Sand _____

Drilling and Remarks:

Gas _____

Oil _____

Total Depth 3275**PRODUCTION**

1st 24 hrs. Nat. _____

1st 24 hrs. after shot. _____

Gas _____ Cu. Ft.

Dry Hole _____

Abandoned _____

Date

AUG 17 1949 19S. J. LEWIS

Scout