


KANSAS
O.W.W.O. Beaver

Section 5 Township 16 Range 12-W

Well No. #1 Hilgenberg

Company Jackson & Lindaley

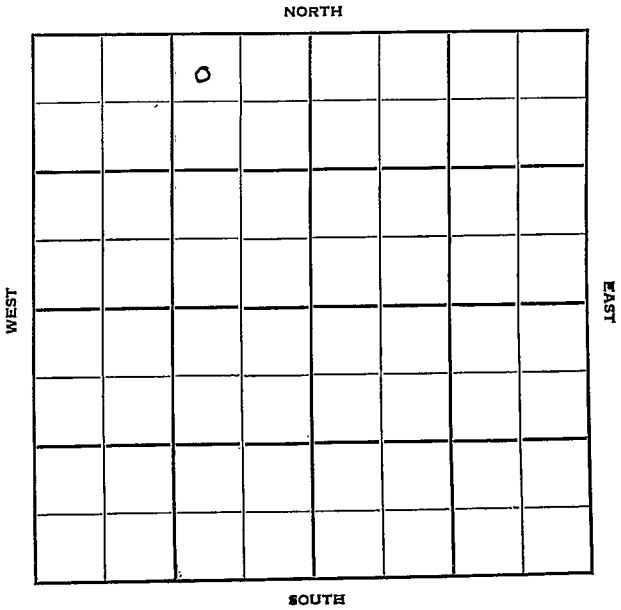

Sec. 5 Twp. _____ R. _____

Well No. #1 Hilgenberg Farm _____

Jackson & Lindsley Company _____

Beaver, NW Contractor _____

330 Ft. from N. Line


_____ Ft. from S. Line

990 Ft. from E. Line

_____ Ft. from W. Line

NW NE NW

Phillips farmout

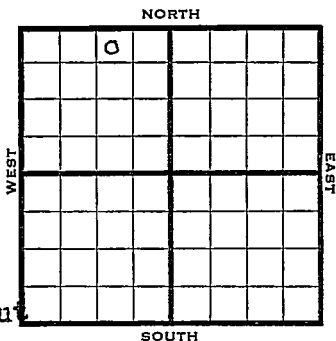

1950 Elev 1822 REPORT

7/12 Spud 7-9-50
8" @ 232
WOC
8/9 8" @ 232
Heeb 2889 Toronto 2906
DST 2834-2915 opn 15 min rec 284' hvy gcm
Lans 2985 Sand 3238-44
Gorham 3253-71 TD
PB 3268 5" @ 3251
40 q5/3251-68 Comp 400 bopd
Completed
COMPLETED

O.W.W.O.

1951
1/31 Oil Well TD 3138
5" @ 3251' OTD 3271 was prod.
Go to 3271 Test 1/4 boph 40 qt/3268-71
test 18 boph 80% wtr 24/3243-69
No inc. SP 3210 12/3156-60 1000 A
S/2 bo 2 bw 2000 A SP 3138
48/3013-21 500 A Test 2 boph 2500 A
S/6 boph Comp. 12 bopd

**FIRST REPORT
COMPLETED**

Map No. _____ Sec. 5 Twp. 16 R. 12W

Well No. 1 Hilgenberg

Jackson & Lindsley Company

Contractor

E. 1822

SECTION PLAT



NV^r NE NW

330 Ft. from N. Line

_____ Ft. from S. Line

990 Ft. from E. Line

_____ Ft. from W. Line

Barton County

Phillips farmout

RECORD

Location _____

Rig up _____

Drilling and Remarks:

Cased _____ in., _____ ft.

Sand _____

Gas _____

Oil _____

Total Depth _____

Spud 7-9-50 /

8" @ 232

WOC

PRODUCTION

1st 24 hrs. Nat. _____

1st 24 hrs. after shot _____

Gas _____ Cu. Ft.

Dry Hole _____

Abandoned _____

Date

JUL 12 1950 19

J. E. TYRA Scout

County Barton State Kansas

Sec. 5 (Blk.) 16 (Sur.) 12W Map No.

Operator Jackson & Lindsley

Well No. 1 Farm Hilgenberg

Elev. 1822 Location NW NE NW

	0				

330 Ft. From N Line NW

990 Ft. From E Line Quarter

1st. Report

Completion AUG 9 1950

Remarks

Spudding Date 7-9-50

Drig. Data NW Beaver Pool

8" @ 232 Heeb. 2889 Toronto 2906

DST 2834-2915 open 15 min. Rec. 284'

hvy gem Lans. 2985 Sand 3238-44

Gorham 3253-71 TD PB 3268 5" @ 3251

40 qt/ 3251-68 Comp. 400 bopd

County Barton State Kansas
 Sec. 5 (Blk.) 16 (Sur.) 12W Map No.
 Operator Jackson & Lindsley
 Well No. 1 Farm Hilgenberg
 Elev. 1822 Location NW NE NW

		0			

330 Ft. From N Line NW
990 Ft. From E Line Quarter
 Ist. Report JAN 31 1951
 Completion JAN 31 1951
 Remarks O.W.W.G.
 Spudding Date O.W.W.G.

Drlg. Data Oil well TD 3138
5" @ 3251 OTD 3271 was prod.
CO to 3271 test $\frac{3}{4}$ boph 40 qt/ 3268-71
test 18 boph 80% water 24/ 3243-69
no inc. SP 3210 12/ 3156-60 1000 A
S/ 2 bo 2 bw 2000 A SP 3138
48/ 3013-21 500 A test 2 boph 2500 A
S/ 6 boph Comp. 12 boph