


Section 5 Township 16 Range 12 W

Well No. # 3 Hilgenberg "A"

Company N C R A

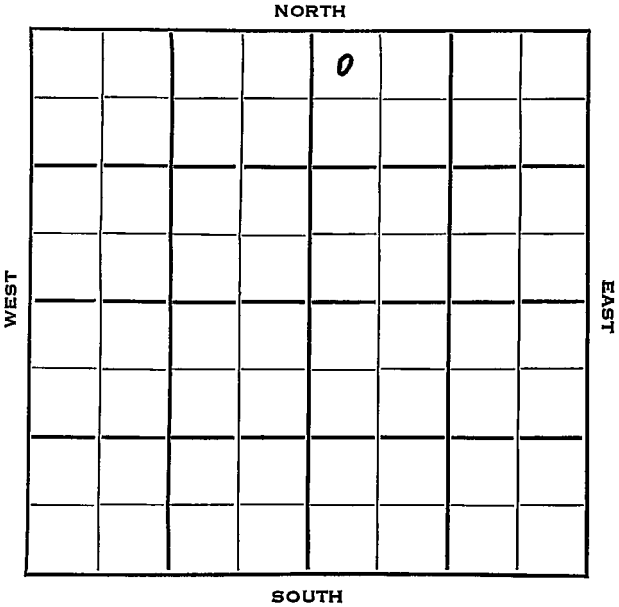

Barton

KANSAS ✓

Sec. 5 Twp. 16 R. 12WWell No. #3 Hilgenberg "A" FarmN C R A

Company

Armer

Contractor

NW Beaver Pool

NORTH

330

Ft. from N. Line


Ft. from S. Line

Ft. from E. Line

330

Ft. from W. Line

NW NW NE

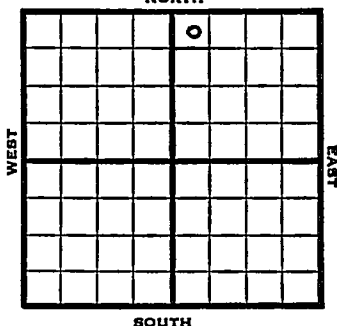

1953 Elev. 1858'

REPORT

7/22

Spud 7-17-53

8" @ 375

Anhy 795

Drlg. 1350'

7/29

Top 2717, Heeb 2939, Tor 2958

DST 2962-70, 2 hrs., 10' VSOCM, 0#

Lans 3040

DST 3042-45, 2 hrs., 8' socm, 0#

DST 3121-29, 2 hrs., 63' SW, 650#

Drlg. 3200'

8/5

Spud 7-17-53

D&A

TD 3337

8" @ 375

Anhy 795½ Top 2717, Heeb 2939, Tor 2958

DST 2962-70, opn 2 hrs., rec. 10'

vsocm, 0#

Lans 3040

DST 3042-45, opn 2 hrs., rec. 8' socm, 0#

DST 3121-29, opn 2hrs., rec. 63' sw, 650#

Cong 3318

TD 3337

D&A

ABANDONED

County Barton State KansasSec. 5 (Blk. Twp.) 16 (Sur. Rge.) 12W Map No. _____Operator N C R AWell No. 3 Farm Hilgenberg "A"Elev. 1858 Location NW NW NE

330 Ft. From N Line NE330 Ft. From W Line Quarter1st. Report JUL 22 1953

Completion _____

Remarks _____

Armer - Contr.Spudding Date 7-17-53Drlg. Data NW Beaver Pool8" @ 375 Anhy 795 drlg. 1350

J. G. McGEHEE