


Section 27 Township 25 Range 14E

Well No. #9 Fuhlhage

Company Brinegar, Brownlee & Alcott

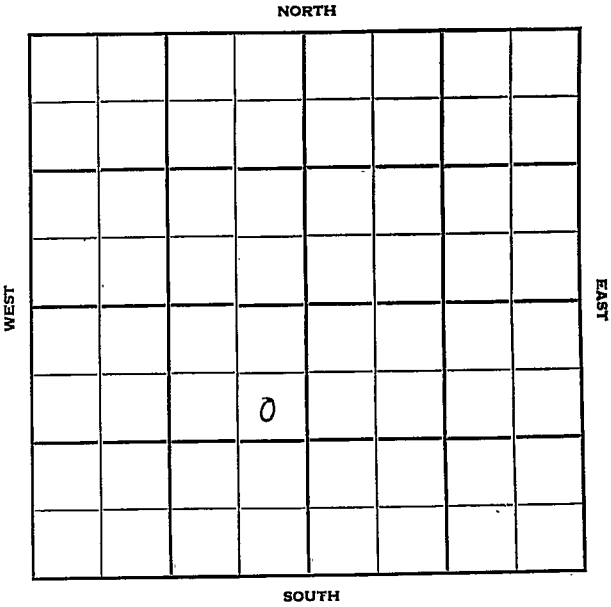

Woodson

KANSAS

Sec. 27 Twp. 25 R. 11 E 1

Well No. # 9 Fuhlhage Farm

Brineger, Brownlee & Alcott Company

Contractor


900 Ft. from N. Line

Ft. from S. Line

510 Ft. from E. Line

Ft. from W. Line

SE NE SW

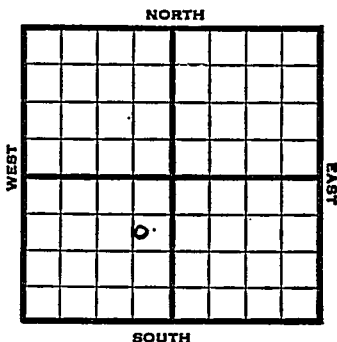

1951

Elev. -

REPORT


4/11

Spud 4-8-51
10" @ 160'

5/2

Spud 4-8-51
8" @ 786' TD 1497
D&A

ABANDONED

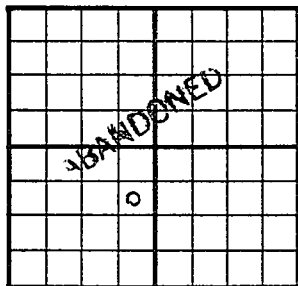County Woodson State KansasSec. 27 (Blk.
Twp.) 2 5 (Sur.
Rge.) 14E Map No.Operator Brinegar, Brownlee & AlcottWell No. 9 Farm FuhlhageElev. Location SE NE SW900 Ft. From N Line SW510 Ft. From E Line Quarter1st. ReportCompletion W/AY 2 1951RemarksSpudding Date 4-8-51Drlg. Data8" @ 786 TD 1497 D & A

J. E. TYRA