


Section 27 Township 25 Range 14E

Well No. #9 Fuhlhage

Company Lincoln Oil

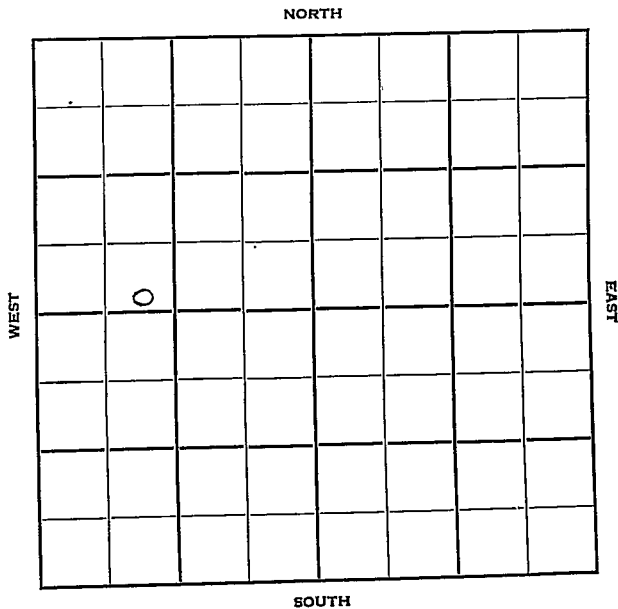

Woodson

KANSAS
14E

Sec. 27 Twp. 25 R. _____

Well No. #9 Fuhlhage Farm _____

Lincoln Oil Company _____


Miscellaneous

_____ Ft. from N. Line

150' Ft. from S. Line

_____ Ft. from E. Line

990' Ft. from W. Line

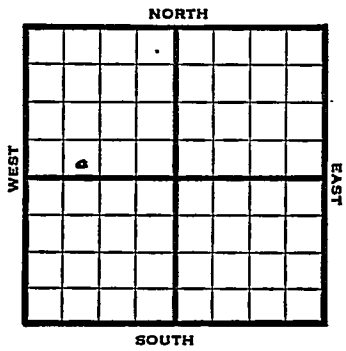

SE SW NW

1950

REPORT

1/11

Spud 1-8-50
10" @ 62'
Drig. 125'

2/15

TD 1510'
10"@ 62'
Bart sd 1460-94'
No shows.
D&A
Aband.

ABANDONED

Map No. _____ Sec. 27 Twp. 25 R. 14EWell No. 9 Fuhlhage

_____ Lincoln Oil _____ Company

_____ Contractor

SE SW NW

SECTION PLAT

FIRST REPORT			
0			

_____ Ft. from N. Line

150 Ft. from S. Line

_____ Ft. from E. Line

990 Ft. from W. Line

Woodson County

Location _____

Rig up _____

Drilling and Remarks:

Spud 1-8-50

10" @ 62

drlg. 125

RECORD

Cased _____ in., _____ ft.

Sand _____

Gas _____

Oil _____

Total Depth _____

PRODUCTION

1st 24 hrs. Nat. _____

1st 24 hrs. after shot _____

Gas _____ Cu. Ft.

Dry Hole _____

Abandoned _____

Date

JAN 11 1950 19J. E. TYRA Scout

Kansas

Map No. _____ Sec. 27 Twp. 25 R. 14E

Well No. 9 Fuhlhage

Lincoln Oil Company

Contractor

SE SW NW

SECTION PLAT

_____ Ft. from N. Line

150 Ft. from S. Line

_____ Ft. from E. Line

990 Ft. from W. Line

ABANDONED			
o			

Woodson County

Location _____

Rig up _____

Drilling and Remarks:

16" @ 62
 Bart sd. 1466-94
 no shows
 D + A

RECORD

Cased _____ in., _____ ft.

Sand _____

Gas _____

Oil _____

Total Depth 1510

PRODUCTION

1st 24 hrs. Nat. _____

1st 24 hrs. after shot _____

Gas _____ Cu. Ft.

Dry Hole _____

Abandoned _____

Date

FEB 15 1950

19

J. E. TYRA Scout