

Map No. Sec. 19 Twp. 25 R. 14-E


Well No. 1-Nordmeyer Farm
Sheedy et al Company

 Ft. from N. Line

330 Ft. from S. Line

 Ft. from E. Line

660 Ft. from W. Line

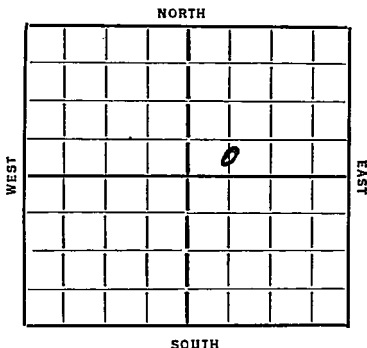

Date
1936

REPORT

4/1 Spud

4/10 Drlg. 725'

4/16 Drlg. 850'

4/22/36- ~~W~~Bartlesville 1404'

T.D. 1470'

D & A

ABANDONED

KANSAS

Map No. 17 Sec. 19 Twp. 25 R. 14 EWell No. F-7 Ford MeyerShedy et al Company

Contractor

FIRST REPORTS

SECTION PLAT

..... Ft. from N. Line

330 Ft. from S. Line

..... Ft. from E. Line

660 Ft. from W. Line

		o	

Location.....

Rig up.....

Drilling and Remarks:

Spud

RECORD

Cased.....in.,ft.

Sand.....

Gas.....

Oil.....

Total Depth.....

PRODUCTION

1st 24 hrs. Nat.....

1st 24 hrs. after shot.....

Gas.....Cu. Ft.

Dry Hole.....

Abandoned.....

Date

4-1-36

192.....

ORVAL MANNSCHRECK

Scout

KANSAS

Map No. 17 Sec. 19 Twp. 25 R. 14 E

Well No. Woodmeyer

Sheddy Company

Contractor

SECTION PLAT

		0	

..... Ft. from N. Line

3.30 Ft. from S. Line

..... Ft. from E. Line

6.60 Ft. from W. Line

ABANDONED

Location.....

Rig up.....

Drilling and Remarks:

Bar. 1404

D & H.

RECORD

Cased..... in., ft.

Sand.....

Gas.....

Oil.....

Total Depth..... 1470

PRODUCTION

1st 24 hrs. Nat.....

1st 24 hrs. after shot.....

Gas..... Cu. Ft.

Dry Hole.....

Abandoned.....

Date

APR 22 1936

S. J. LEWIS

192.....

Scout