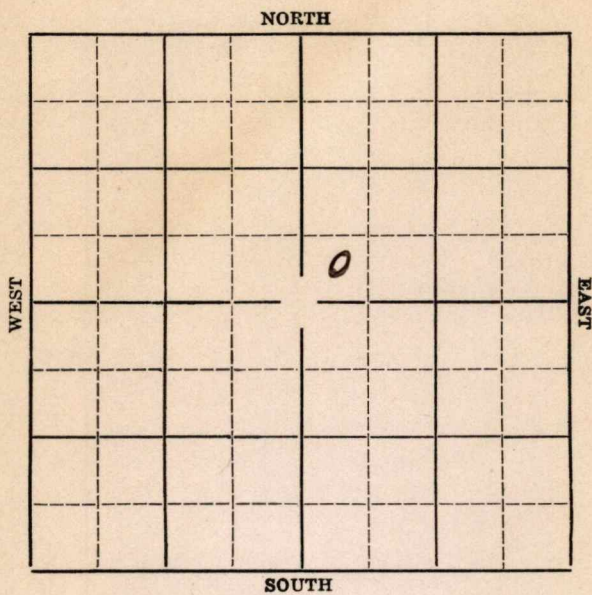


Section 15 Township 28 Range 7-EWell Number 1-RampCompany Armour & Brant et al

Well No. 1-Ramp Farm _____

Armour & Brant et al Company


Ft. from N. Line

330 Ft. from S. Line

Ft. from E. Line

330 Ft. from W. Line

Elev. 1411

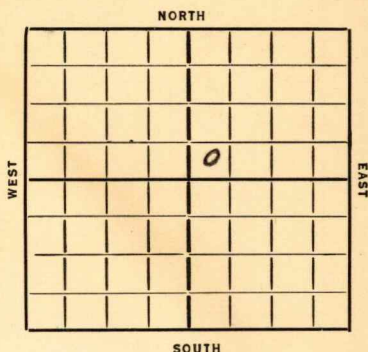

Date
1936

REPORT

4/15	Rig
------	-----

4/23 Rigging up.

4/30 S.D. at 582'.

5/7 Drlg. 1115'.

5/14 Drlg. 1502'.

5/21 Shut down.

5/28 --

6/4 Miss Lime 2692'. T.D. 2707'.

400' oil in 8 hours. 1000 gallons
of acid.

6/17/36-Miss. Lime. 2692'.

1000 gallons acid.

T.D. 2707'.

Potential 195 bbls of oil.

COMPLETED

KANSAS

Map No. 10 Sec. 15 Twp. 28 R. 7EWell No. 1 Ramp.Armour & Brant & Co. Company

Contractor

SECTION PLAT

Ft. from N. Line

330 Ft. from S. Line

Ft. from E. Line

330 Ft. from W. Line

FIRST REPORT

		0	

Location

Rig up

Drilling and Remarks:

Rig

RECORD

Cased in., ft.

Sand

Gas

Oil

Total Depth

PRODUCTION

1st 24 hrs. Nat.

1st 24 hrs. after shot

Gas Cu. Ft.

Dry Hole

Abandoned

Date

APR 15 1936

192

S. J. LEWIS

Scout

Map No. 10 Sec. 15 Twp. 28 R. 7E

Well No. 1 Ramp

Armour & Brand et al Company

Contractor

SECTION PLAT

_____ Ft. from N. Line

320 Ft. from S. Line

_____ Ft. from E. Line

220 Ft. from W. Line

COMPLETED

Location _____

Rig up _____

Drilling and Remarks:

Miss L 2892

1000 acid

Pat 195 Hk

RECORD

Cased _____ in., _____ ft.

Sand _____

Gas _____

Oil _____

Total Depth 2707

PRODUCTION

1st 24 hrs. Nat. _____

1st 24 hrs. after shot _____

Gas _____ Cu. Ft.

Dry Hole _____

Abandoned _____

Date

JUN 17 1936

19

S. J. LEWIS

Scout