


Map No. 10 Sec. 16 Twp. 28 R. 7

Well No. 1 Dunn Farm

Allen et al Company

NORTH

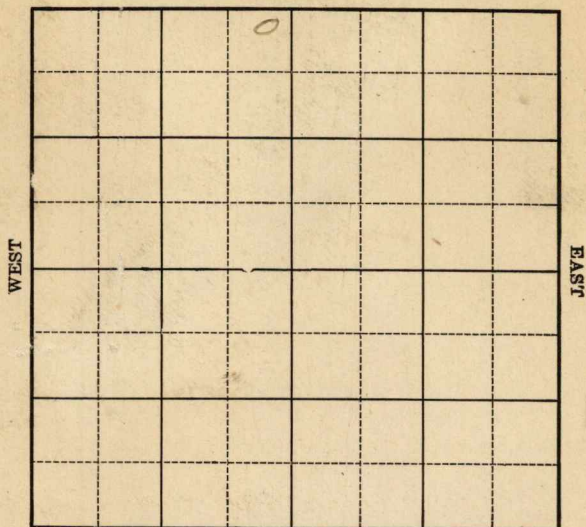

SOUTH

Location _____

Drilling Remarks

Rig Up

Drilling Remarks

RECORD

Cased _____ in. _____ ft.

Sand _____

Gas

Oil

Total Depth _____

PRODUCTION

1st 24 hrs. Nat. _____

1st 24 hrs. after shot -----

Gas.....cu. ft.

Dry Hole-----

Abandoned

Map No. KANSAS Sec. 16 Twp. 28 R. 7


 Well No. 1 L Quinn Farm
Allen et al. Company

250 Ft. from N. Line

Ft. from S. Line

250 Ft. from E. Line

Ft. from W. Line

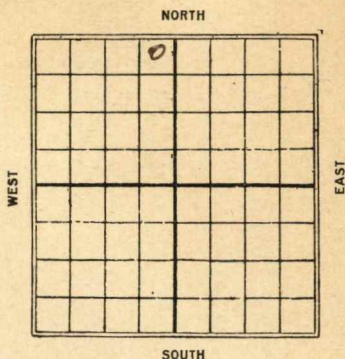
1925

Date REPORT

10/22 Location
10/29 Timbers
11/6 Rig
11-13 Spudded 90 S/O.
11/19 S/O 125
11/27 Only 950
12/3 ✓ 1260
12/10 ✓ 1527
12/17 Only 1975'
12/23 Only 2180'
12/31 Only 2310
1926
1/8 Only 2710
1/14 Top line 2710' small show
oil 2720-22' slate 2740-45'
Only 2760
50 ~~Top line~~ show oil 2860
-62' 1 hailer oil & HFW.
U. R. 6"
1/27 Top line 2710 small show
2720-22' show oil 2860-62'
& HFW. D & A. Y. D. 3161

Map No. K10 KANSAS Sec. 16 Twp. 28 R. 7

Well No. 1 Dunn
Allen et al Company

Contractor

SECTION PLAT

250 Ft. from N. Line

_____ Ft. from S. Line

250 Ft. from E. Line

_____ Ft. from W. Line

FIRST REPORTS

Location ☒

Rig up _____

Drilling and Remarks:

RECORD

Cased _____ in., _____ ft.

Sand _____

Gas _____

Oil _____

Total Depth _____

PRODUCTION

1st 24 hrs. Nat. _____

1st 24 hrs. after shot _____

Gas _____ Cu. Ft.

Dry Hole _____

Abandoned _____

Date

OCT 22 1925

192

CHAS. L. SHERWOOD

Scout

10 KANSAS Sec. 16 Twp. 28 R. 7

Well No. 1 Dunn

Allen et al

Company

Contractor

COMPLETED

SECTION PLAT

250

Ft. from N. Line

Ft. from S. Line

250

Ft. from E. Line

Ft. from W. Line

ABANDONED

Location

Rig up

Drilling and Remarks:

Top line 2710'
small show 2720-22'
show oil 2960-62'
and AFH.

Dup 2 at 5
2 1/2 3161'

RECORD

Cased in., ft.

Sand

Gas

Oil

Total Depth 3161'

PRODUCTION

1st 24 hrs. Nat.

1st 24 hrs. after shot

Gas Cu. Ft.

Dry Hole

Abandoned

Date

JAN 27 1926

192

CHAS. L. SHERWOOD

Scout