


Section 16 Township 28 Range 7-E

Well No. #4 Greely

Company Rex & Morris

NORTH Brandt Pool

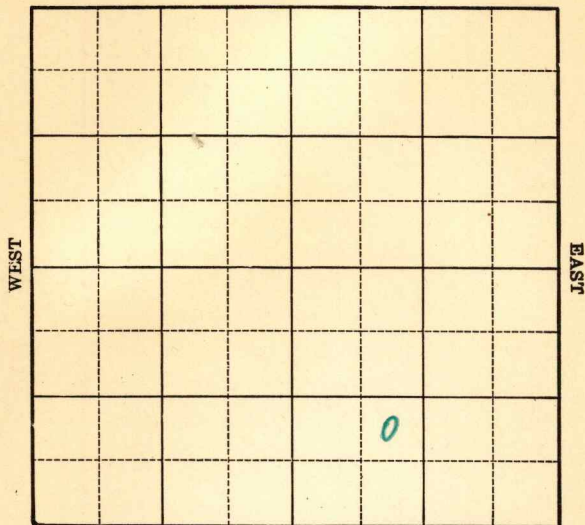

SOUTH

Map No. 10 Sec. 16 Twp. 28 R. 7EWell No. 4 GreelyRex & Morris CompanyFIRST REPORT Contractor

NE SW SE

 Ft. from N. Line990 Ft. from S. Line Ft. from E. Line990 Ft. from W. Line

BRANDT POOL

SECTION PLAT

Location Rig up

Drilling and Remarks:

Material

RECORD

Cased in., ft.Sand Gas Oil Total Depth

PRODUCTION

1st 24 hrs. Nat. 1st 24 hrs. after shot Gas Cu. Ft.Dry Hole Abandoned

Date

JAN 22 1941

19

S. J. LEWIS Scout

Map No. 10 Sec. 16 Twp. 28 R. 7EWell No. 4 GreelyRex & Morris CompanyABANDONED Contractor

NE SW SE

 Ft. from N. Line990 Ft. from S. Line Ft. from E. Line990 Ft. from W. Line

BRANDT POOL

SECTION PLAT

Location Rig up

Drilling and Remarks:

*Miss 2664**7" C 2666**Water.*

RECORD

Cased in., ft.Sand Gas Oil Total Depth 2719

PRODUCTION

1st 24 hrs. Nat. 1st 24 hrs. after shot Gas Cu. Ft.Dry Hole Abandoned

Date

MAR 5 1941 19

S. J. LEWIS

Scout