

KANSAS

Form 51-5M-7-40-Palace


Butler

Section 16 Township 28 Range 7-E

Well No. #1 Whitmar

Company Rex & Morris

NORTH Brandt Pool

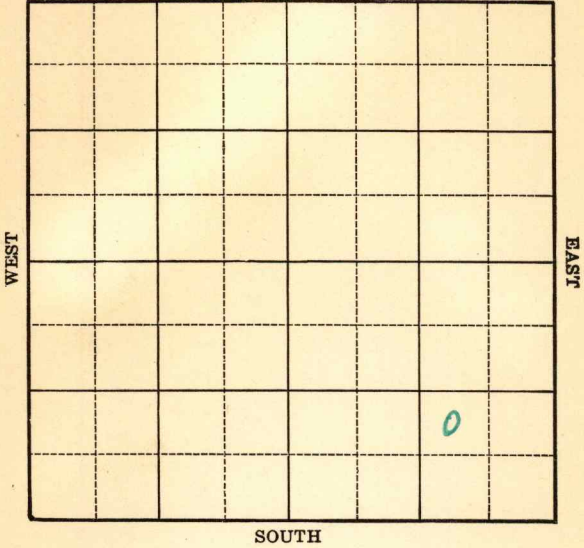

Map No. 10 Sec. 16 Twp. 28 R. 7E

Well No. 1 Whitmar

Rex & Morris Company

Contractor

FIRST REPORT
NW SE SE

SECTION PLAT

			10

_____ Ft. from N. Line

990 Ft. from S. Line

990 Ft. from E. Line

_____ Ft. from W. Line

BRANDT POOL

Location _____

Rig up _____

Drilling and Remarks:

Machine

RECORD

Cased _____ in., _____ ft.

Sand _____

Gas _____

Oil _____

Total Depth _____

PRODUCTION

1st 24 hrs. Nat. _____

1st 24 hrs. after shot _____

Gas _____ Cu. Ft.

Dry Hole _____

Abandoned _____

Date

AUG 21 1940

19

S. J. LEWIS Scout

Map No. 10 Sec. 16 Twp. 28 R. 7E

Well No. 1 Whitmar

Rex & Morris Company

Contractor

COMPLETED

SECTION PLAT

NW SE SE

_____ Ft. from N. Line

990 Ft. from S. Line

990 Ft. from E. Line

_____ Ft. from W. Line

BRANDT POOL

			6

Location _____

Rig up _____

Drilling and Remarks:

Miss 2663
5" @ 2665-
2000 acid
Pump. 557 Pt.

RECORD

Cased _____ in., _____ ft.

Sand _____

Gas _____

Oil _____

Total Depth 2687

PRODUCTION

1st 24 hrs. Nat. _____

1st 24 hrs. after shot _____

Gas _____ Cu. Ft.

Dry Hole _____

Abandoned _____

Date

SEP 25 1940 19

S. J. LEWIS Scout