


Section.....18.....Township.....28.....Range.....7-E.....


Well Number.....1 Doornboss.....

Company.....Westgate Greenland.....

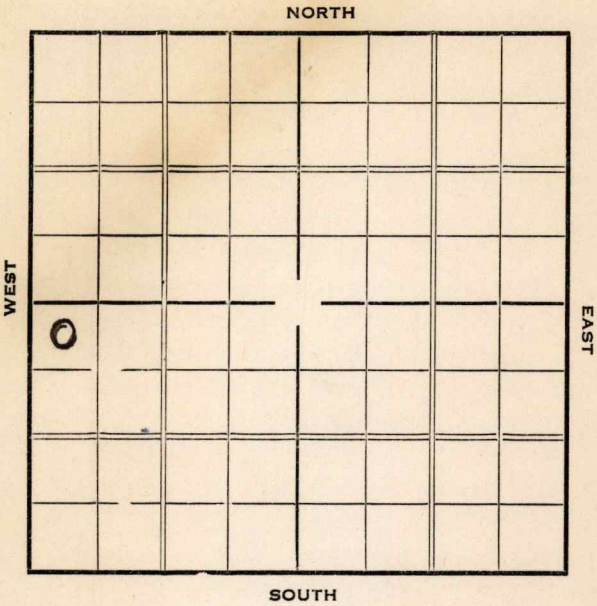

Sec. 18 Twp. 28 R. 7-EWell No. #1 Doornboss FarmWestgate-Greenland Company330 Ft. from N. Line Ft. from S. Line Ft. from E. Line330 Ft. from W. Line

NORTH

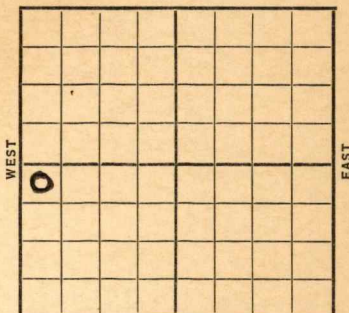

Elev. 1402

Date	REPORT
1937	
4/21	Rig
4/30	"
5/7	Drlg. 545'.
5/14	12" @ 948'. Drlg. 1320'.
5/21	10" @ 1623'. Drlg. 1940'.
5/28	8" @ 2227'. Drlg. 2230'.
6/4	Bart. 2699'. Miss. 2752'.
	SD 2754'.
6/11	" "
6/19	" "
6/25	" "
6/30	Miss. 2752'.
	T.D. 2754'.
	ABANDONED

KANSAS *Butler*Map No. 10 Sec. 18 Twp. 28 R. 7EWell No. 1 DoornbussWestgate Greenland Company

Contractor

SECTION PLAT

0			

330 Ft. from N. Line

_____ Ft. from S. Line

_____ Ft. from E. Line

330 Ft. from W. Line

FIRST REPORT

Location _____

Rig up _____

Drilling and Remarks:

Rig

RECORD

Cased _____ in., _____ ft.

Sand _____

Gas _____

Oil _____

Total Depth _____

PRODUCTION

1st 24 hrs. Nat. _____

1st 24 hrs. after shot _____

Gas _____ Cu. Ft.

Dry Hole _____

Abandoned _____

Date

APR 21 1937

19

S. J. LEWIS Scout

Butler KANSAS

Map No. 10 Sec. 18 Twp. 28 R. 7EWell No. 1 - DoornbossWestgate - Greenland Company

Contractor

ABANDONED

SECTION PLAT

0			

330 Ft. from N. Line

_____ Ft. from S. Line

_____ Ft. from E. Line

330 Ft. from W. Line

Location _____

Rig up _____

Drilling and Remarks:

D & A

RECORD

Cased _____ in., _____ ft.

Sand MISS 2752

Gas _____

Oil _____

Total Depth 2754

PRODUCTION

1st 24 hrs. Nat. _____

1st 24 hrs. after shot _____

Gas _____ Cu. Ft.

Dry Hole _____

Abandoned _____

Date

H. D. Hatfield

JUN 30 1937 19

Scout