

Section 5 Township 16 Range 12W

Well No. 4 Standinger "A"

Company Phillips & Hansen

NORTH

WEST

EAST

SOUTH

KANSAS

Sec. 5 Twp. 16 R. 12W

Well No. 4 Standinger "A" Farm

Phillips & Hansen Company

Phillips & Hansen - Contractor


 Ft. from N. Line

990 Ft. from S. Line

 Ft. from E. Line

990 Ft. from W. Line

NE SW SW

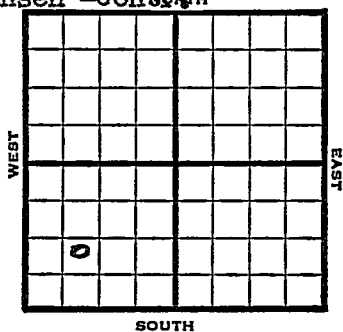

1949 Elev 1854' REPORT

9/28 Surface Hole
10/5 8" @ 515'
Drlg 2769' -
10/12 Lansing 3026' -
Quartzite 3276-77
TD 3277'
5" @ 3276'
10/19 TD 3288'
10/26 "
11/1 "
11/9 TD 3288'
Quartzite 3276'
5" @ 3276'
Pump 36 Oil $\neq$ 73 % W Pot
42° Gr.
Comp

COMPLETED

Map No. _____ Sec. 5 Twp. 16 R. 12W

Well No. 4 Standinger "A"

Phillips & Hansen Company

Phillips & Hansen Contractor

NE SW SW

**FIRST REPORT
SECTION PLAT**

_____ Ft. from N. Line

990 Ft. from S. Line

_____ Ft. from E. Line

990 Ft. from W. Line

<i>d</i>			

Barton County

Location _____

Rig up _____

Drilling and Remarks:
surface hole

RECORD

Cased _____ in., _____ ft.

Sand _____

Gas _____

Oil _____

Total Depth _____

PRODUCTION

1st 24 hrs. Nat. _____

1st 24 hrs. after shot _____

Gas _____ Cu. Ft.

Dry Hole _____

Abandoned _____

Date

SEP 28 1949 19 S. J. LEWIS Scout

Kansas

Map No. _____ Sec. 5 Twp. 16 R. 12WWell No. 4 Standinger "A"_____
Phillips & Hansen Company

COMPLETE

Contractor

NE SW SW

E 11/18/54
SECTION PLAT_____
Ft. from N. Line990
Ft. from S. Line_____
Ft. from E. Line990
Ft. from W. Line

Barton County

Location _____

Rig up _____

Drilling and Remarks:

Quartzite 3276
*5" CB 276**Imp Soil + 78% H₂O*
*28"**42° SW*

RECORD

Cased _____ in., _____ ft.

Sand _____

Gas _____

Oil _____

Total Depth 7288'

PRODUCTION

1st 24 hrs. Nat. _____

1st 24 hrs. after shot _____

Gas _____ Cu. Ft.

Dry Hole _____

Abandoned _____

Date

NOV 9 1949 19

S. J. LEWIS Scout