


Section 5 Township 16 Range 12 WWell No. # 5 Staudinger (A)Company L. E. Phillips

NORTH

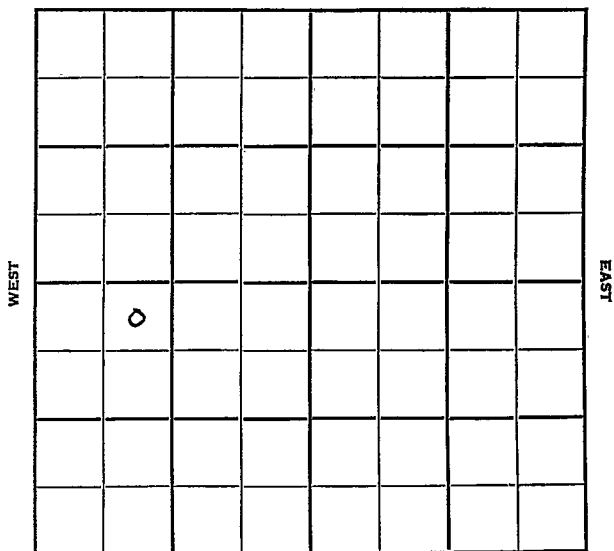

SOUTH

Barton

KANSAS

Sec. 5 Twp. 16 R. 12W

Well No. #5 Staudinger (A) Farm

L. E. Phillips Company

Brock - Contr. Contractor


Beaver
330' Ft. from N. Line

 Ft. from S. Line

 Ft. from E. Line

990' Ft. from W. Line

NE NW SW

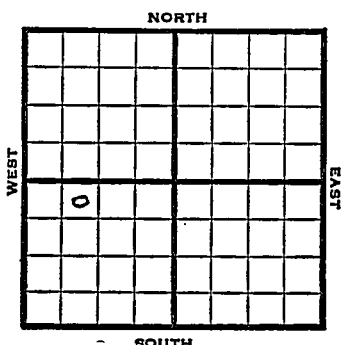


1951	Elev. 1843' REPORT
9/26 11/7	Location Spud 9-25-51 Oil Well TD 3269 8" @ 489 Anhy 775 Heeb. 2900 Tor. 2916 Lans. 2995 Qtz. 3236 TD 3246 5" @ 3240 DD 3269 PB 3230 16/ 3164-69 500 A S/ 4 BFPH 99% wtr. PB 3100 12/ 3077-81 SSO & wtr. 1000 A S/ 30 BFPH 99% wtr. PB 3070 12/ 3062-66 SSO 500 A S/ 5 BOPH 18/ 3020-26 2000 A Comp. 207 BOPD 3% wtr. COMPLETED

County Barton State Kansas
 Sec. 5 (Blk.) 16 (Sur.) 12W Map No.

Operator L. E. Phillips

Well No. 5 Farm

Elev. 1843 Location NE NW SW

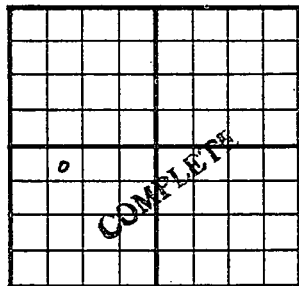

330 Ft. From N Line SW

990 Ft. From W Line Quarter

Ist. Report

Completion NOV 7 1951

Remarks Beaver Pool

Brock - Contr.

Spudding Date 9-25-51

Drlg. Data Oil well TD 3269

8" @ 489 Anhy 775 Heeb. 2900

Tor. 2916 Lans. 2995 Qtz. 3236

TD 3246 5" @ 3240 DD 3269 PB 3230

16/ 3164-69 500 A S/ 4 bfph 99% water

PB 3100 12/ 3077-81 SSO & water 1000 A

S/ 30 bfph 99% water PB 3070

12/ 3062-66 SSO 500 A S/ 5 boph

18/ 3020-26 2000 A Comp. 207 bopd 3% wat

J. E. TYRA