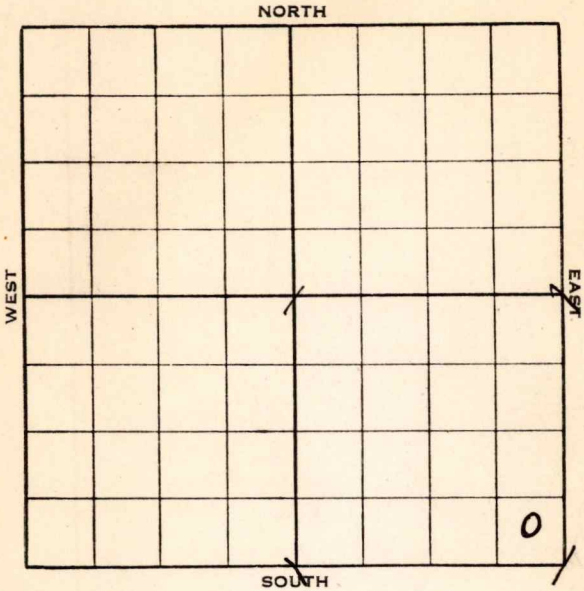


Butler

FORM 51 5M 2-38 TPCO.

Section 22 Township 28 Range 7-EWell No. Cannon
1 NelsonCompany White + Ellis
Rex & Morris et al

KANSAS

Butler


O.W.W.O.

Sec. 22 Twp. 28 R. 7-EWell No. #1 Cannon FarmRex & Morris et al Company
White & Ellis

Ft. from N. Line

330 Ft. from S. Line330 Ft. from E. Line

Ft. from W. Line

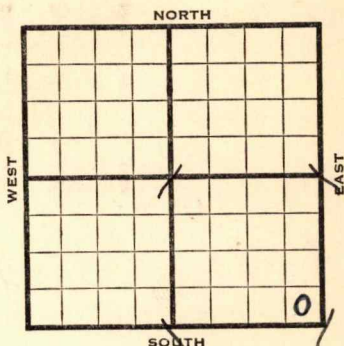

Elev. 1544

1938	REPORT
8/17	Mat'l.
8/26	12" - 815'. Dlg. 825'.
9/2	10" - 1597'. Dlg. 1685'.
9/9	8" - 2286'. S. O. 2420-35'. Dlg. 2490'.
9/14	6" - 2812'. Miss. 2808'. T. D. 2867'. H. F. W.
	ABANDONED
1952	O.W.W.O.
1/9	KC 2067' Miss 2808-67' TD Was Dry. CO to 2553' Prue Sd 2437-47' Sand 2454-61' 5" @ 2437' CO to 2490' Hydf.
1/30	Oil Well TD 2460 KC 2067 Miss 2808-67 OTD 2867 CO to 2553 Prue Sand 2437-47 Sd 2454-61 5" @ 2437 CO to 2490 Hydra. Comp. 25 bopd

COMPLETE

Map No. 10 Sec. 22 Twp. 28 R. 7EWell No. 1 NelsonRex & Morris etal Company

Contractor

ABANDONED

SE/C

 Ft. from N. Line330 Ft. from S. Line330 Ft. from E. Line Ft. from W. Line

SECTION PLAT

			0

Location Rig up

Drilling and Remarks:

HFW

D & A

RECORD

Cased 6 in., 2812 ft.Sand MISS 2808Gas Oil Total Depth 2867

PRODUCTION

1st 24 hrs. Nat. 1st 24 hrs. after shot Gas Cu. Ft.Dry Hole Abandoned

Date

SEP 14 1938

19

H. D. Hatfield Scout

Butler

KANSAS

Map No. 10 Sec. 22 Twp. 28 R. 7EWell No. 1 NelsonRex & Morris etal

Company


Contractor

FIRST REPORT

SE/C

 Ft. from N. Line330 Ft. from S. Line330 Ft. from E. Line Ft. from W. Line

SECTION PLAT

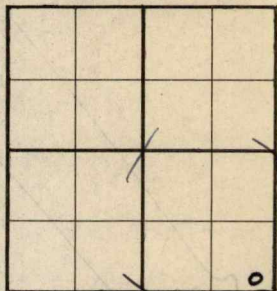Location Rig up

Drilling and Remarks:

Matl.

RECORD

Cased in., ft.Sand Gas Oil Total Depth

PRODUCTION

1st 24 hrs. Nat. 1st 24 hrs. after shot Gas Cu. Ft.Dry Hole Abandoned

Date

AUG 17 1938

19

H. D. Hatfield Scout

County Butler State Kansas
 Sec. 22 (Blk. 28) (Sur. 7E) Map No.

Operator White & Ellis

Well No. 1 Farm Cannon

Elev. 1544 Location SE SE SE



330 Ft. From S Line SE

330 Ft. From E Line Quarter

1st. Report

Completion JAN 30 1952

Remarks OWWO

Spudding Date

Drlg. Data Oil well TD 2460

KC 2067 Miss. 2808-67 OTD 2867

CO to 2553 Prue sand 2437-47 Sd. 2454-

61 5" @ 2437 CO to 2490 Hydro.

CO to 2550 PB 2460 Hydro.

Comp. 25 bopd