

Section 22 Township 28 Range 7E

Well No. #2 Cannon

Company White & Ellis

NORTH

WEST

EAST

SOUTH

Butler

KANSAS

Sec. 22 Twp. 28 R. 7E

Well No. #2 Cannon Farm

White & Ellis Company

White & Ellis Contractor


 Ft. from N. Line

330 Ft. from S. Line

990 Ft. from E. Line

 Ft. from W. Line

SW SE SE

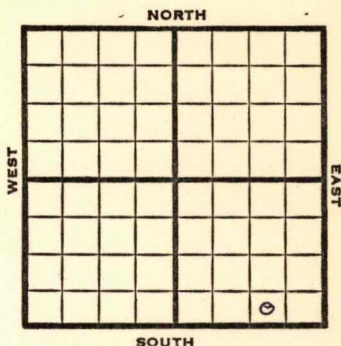

1952 **Elev. 1534'** REPORT

2/20 Spud 2-15-52
8" @ 60'

Lans. 1715 Drlg. 1930'

3/19 Spud 2-15-52
Oil well TD 2469' 8" @ 60
Lans. 1715' KC 2077' Prue sand
2435' 4" @ 2435' CO to 2469' TD
PB 2458' Hydro. Comp. 15 BOPD

COMPLETED

County	Butler		State	Kansas	
Sec.	22	(Blk. Twp.)	28	(Sur. Rge.)	7E Map No.
Operator	White & Ellis				
Well No.	2	Farm	Cannon		
Elev.			Location	SW SE SE	
			330 Ft. From	S Line	SE
			990 Ft. From	E Line	Quarter
			1st. Report FEB 20 1952		
			Completion		
			Remarks		
			White & Ellis - Contr.		
			Spudding Date 2-15-52		

Drlg. Data

8" @ 60 Lans. 1715 drlg. 1930

J. G. McGEHEE

