


Section 21 Township 28 Range 7-E

Well No. 1 J. M. Evans

Company Simpson Oil et al

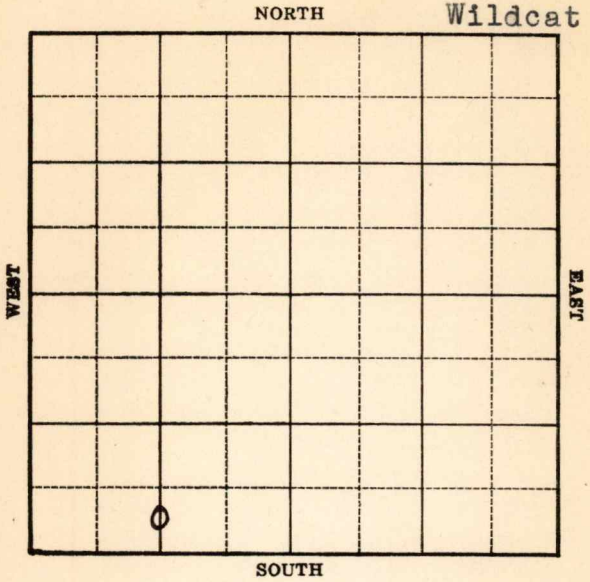

1939

6/7--Arb. 3201

T.D. 3217

HFW

ABANDONED

Butler

KANSAS

Map No. 10 Sec. 21 Twp. 28 R. 7E

Well No. 1 J. M. Evans

Simpson Oil etal Company

Contractor

FIRST REPORT

C S L SW

_____ Ft. from N. Line

330 Ft. from S. Line

_____ Ft. from E. Line

1320 Ft. from W. Line

SECTION PLAT

WILDCAT

Location _____

Rig up _____

Drilling and Remarks:

Mach.

RECORD

Cased _____ in., _____ ft.

Sand _____

Gas _____

Oil _____

Total Depth _____

PRODUCTION

1st 24 hrs. Nat. _____

1st 24 hrs. after shot _____

Gas _____ Cu. Ft.

Dry Hole _____

Abandoned _____

Date

MAR 1 - 1939 19 H. D. Hatfield Scout

Butler

Map No. 10 Sec. 21 Twp. 28 R. 7E

Well No. 1 J. M. Evans

Simpson Oil etal Company

Contractor

ABANDONED

C S L SW

 Ft. from N. Line

330 Ft. from S. Line

 Ft. from E. Line

1320 Ft. from W. Line

SECTION PLAT

WILDCAT

Location

Rig up

Drilling and Remarks:

Per 3201

HFW.

RECORD

Cased in., ft.

Sand

Gas

Oil

Total Depth 3217

PRODUCTION

1st 24 hrs. Nat.

1st 24 hrs. after shot

Gas Cu. Ft.

Dry Hole

Abandoned

Date

JUN 7 1939 19

S. J. LEWIS

Scout