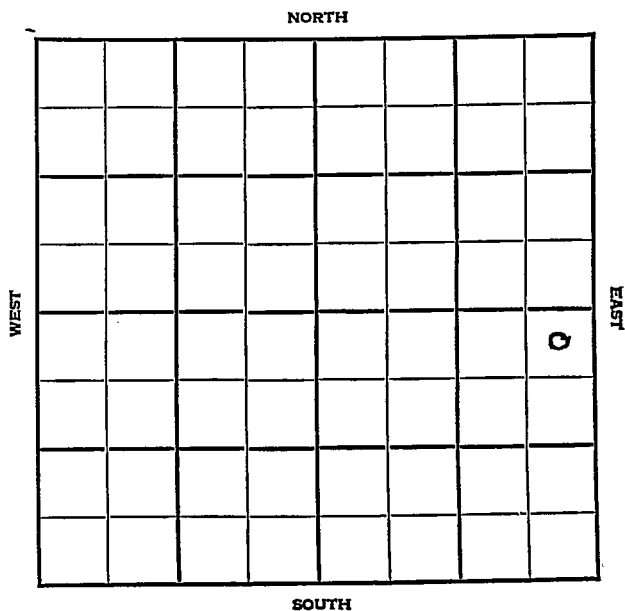


Section 6 Township 16E Range 12WWell No. #3 DepiesseCompany Franco Central etal

KANSAS

Barton

Sec. 6 Twp. 16 R. 12W

Well No. #3 Depiesse Farm

Franco Central et al Company
Kraft-Prusa-Pool


330' Ft. from N. Line

 Ft. from S. Line

330' Ft. from E. Line

 Ft. from W. Line

NE SE

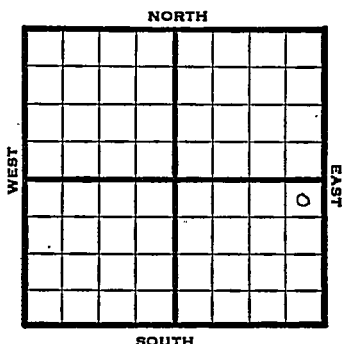

1948 Elev. 1840' REPORT

6/9	Drlg. 1040'
6/16	12" @ 400'
	10" @ 791'
	Drlg. 2195'
6/23	8" @ 2425'
	Drlg 2440
6/29	Drlg. 2870'
7/8	Lansing 3008'
	7" @ 3042'
	TD 3185'
	400' oil 3 hrs.
7/14	"
7/21	"
7/28	"
8/4	"
8/11	Lans. 3008'
	7" @ 3042'
	TD 3185'
	Depth Pot. 2692 oil & 7% W Pot.
	Gr. 42°
	COMPLETED

Map No. _____ Sec. 6 Twp. 16 R. 12W

Well No. 3 Depiesse

Franco Central etal. Company

FIRST REPORT Contractor

NE SE

SECTION PLAT

330 Ft. from N. Line

_____ Ft. from S. Line

330 Ft. from E. Line

_____ Ft. from W. Line

			b

Barton County

Location _____

Rig up _____

Drilling and Remarks:

drlg. 1040

RECORD

Cased _____ in., _____ ft.

Sand _____

Gas _____

Oil _____

Total Depth _____

PRODUCTION

1st 24 hrs. Nat. _____

1st 24 hrs. after shot _____

Gas _____ Cu. Ft.

Dry Hole _____

Abandoned _____

Date

JUN 9 1948

19

S. J. LEWIS

Scout

