


Woodson
25 R. 14E

Map No. **KANSAS** Sec. **20** Twp. **25** R. **14E**

Well No. **J. Kliche** Farm
Cornell & Marshall Company

NORTH

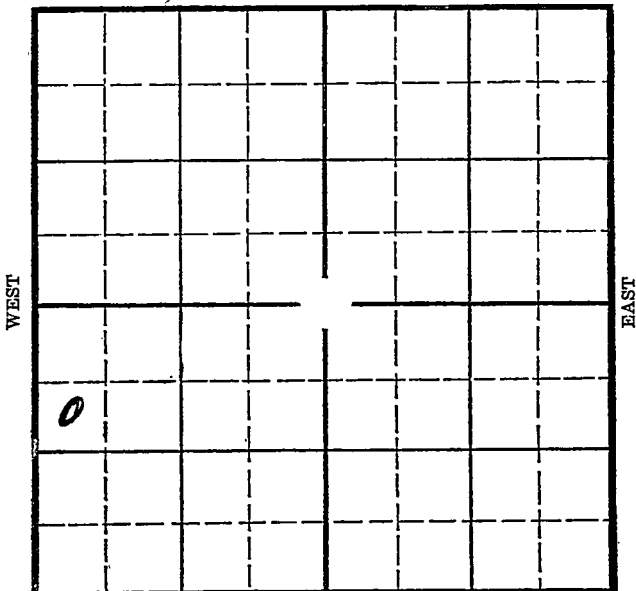

SOUTH

Location _____
Drilling Remarks _____

Rig Up _____
Drilling Remarks _____

RECORD

PRODUCTION

Cased _____ in. _____ ft.
Sand _____
Gas _____
Oil _____
Total Depth _____

1st 24 hrs. Nat. _____
1st 24 hrs. after shot _____
Gas _____ cu. ft. _____
Dry Hole _____
Abandoned _____

Woodrow

Map No. KANSAS Sec. 20 Twp. 25 R. 14E


Well No. 1- Klick Farm
Connell & Marshall Company

990 Ft. from N. Line

Ft. from S. Line

Ft. from E. Line

330 Ft. from W. Line

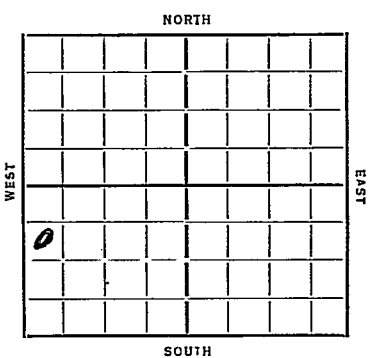

Date	REPORT
1935	
6/5	Spud
6/13	dly 77
6/20	Spud
6/28	—
7/3	dly 10.80
7/11	B.G. 1390-96 1 1/2 m Gas
7/18	Spray oil
8/1	(40' T-7) flow 150 bbls
8/8	per day
8/14	Shot Noo etc @ 0
	flow 5 bbls P/H
	Sand 1390-96
	T-7 1437
	flow 548 bbls
	COMPLETED

Map No. 17 Sec. 20 Twp. 25 R. 14 E

Well No. 1- Klick

Connell & Marshall Company

Contractor

7 FT REPORTS

SECTION PLAT

990 Ft. from N. Line

..... Ft. from S. Line

..... Ft. from E. Line

330 Ft. from W. Line

0			

Location.....

Rig up.....

Drilling and Remarks:

Spud

RECORD

Cased..... in., ft.

Sand.....

Gas.....

Oil.....

Total Depth.....

PRODUCTION

1st 24 hrs. Nat.....

1st 24 hrs. after shot.....

Gas..... Cu. Ft.

Dry Hole.....

Abandoned.....

Date

6-5-35

192.....

BY AT MANUFACTURERS

Scout

Map No. 17 Sec. 20 Twp. 25 R. 14 E

Well No. F. Klick
Connell & Marshall Company

Contractor

COMPLETED

SECTION PLAT

990 Ft. from N. Line

..... Ft. from S. Line

..... Ft. from E. Line

330 Ft. from W. Line

Location.....

Rig up.....

Drilling and Remarks:

flow
548 bbls

RECORD

Cased..... in., ft.

Sand 1390-96

Gas.....

Oil.....

Total Depth 1437

PRODUCTION

1st 24 hrs. Nat.....

1st 24 hrs. after shot.....

Gas..... Cu. Ft.

Dry Hole.....

Abandoned.....

Date

8-14-35 192

DEVAL MANTHRECK

Scout