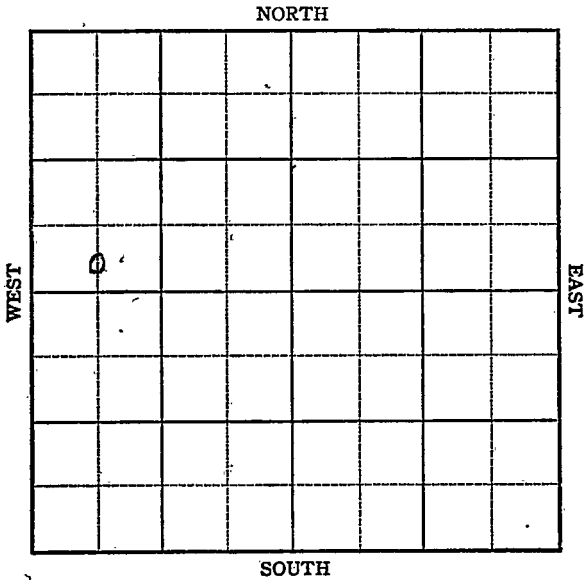


KANSAS

Woodson

FORM 51 IOM 12-46 PETROL

Section 19 Township 25 Range 14EWell No. 5 ⁴ ordmyer (K65 DRL)Company Sheedy et al

Woodson KANSAS ✓

Sec. 19 Twp. 25 R. 14E

Well No. 5⁴ Nordmyer (KGS DRL) Farm

Sheedy et al Company

Misc.


 Ft. from N. Line

330 Ft. from S. Line

 Ft. from E. Line

660 Ft. from W. Line

C S L SW NW

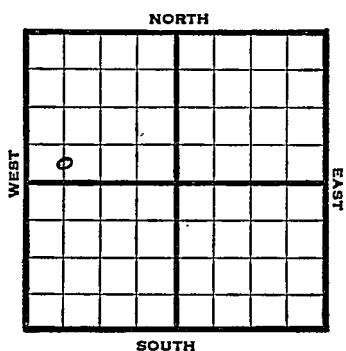

1947

REPORT

5/14 12" @ 134'
10" @ 653'
705'

5/20 8" @ 1137'
Drlg 1355'

5/27 " "

6/4 6" @ 1429'
TD 1473'

ABANDONED

Map No. K17 Sec. 19 Twp. 25 R. 14EWell No. 54 Wardmyer (K65 DRL)

Sheedy Etal.

Company

FIRST REPORT

Contractor

C E L SW NW

SECTION PLAT

0			

Ft. from N. Line

330 Ft. from S. Line

Ft. from E. Line

660 Ft. from W. Line

Woodson County

Location

Rig up

Drilling and Remarks:

12" @ 134'

10" @ 653'

705'

RECORD

Cased _____ in. _____ ft.

Sand _____

Gas _____

Oil _____

Total Depth _____

PRODUCTION

1st 24 hrs. Nat. _____

1st 24 hrs. after shot _____

Gas _____ Cu. Ft.

Dry Hole _____

Abandoned _____

Date

MAY 14 1947

19

S. J. LEWIS

Scout

Please check well
No.
we show another #4
in this 40 acres
advised
Jan

Misc. Small Maps

Cards

Tracing

France Map

Scarborough Map

Pierce Map

Ceological Dept.

Pierce Plat Book

Map No. 17 Sec. 19 Twp. 25 R. 14EWell No. 5 Nordmyer (CKGS, DRL)Sheedy et al. Company**ABANDONED**

Contractor

C. S. L. SW NW

SECTION PLAT

0			

 Ft. from N. Line330 Ft. from S. Line Ft. from E. Line660 Ft. from W. LineWoodson CountyLocation Rig up

Drilling and Remarks:

6" @ 1429

RECORD

Cased in., ft.Sand Gas Oil Total Depth 1429

PRODUCTION

1st 24 hrs. Nat. 1st 24 hrs. after shot Gas Cu. Ft.Dry Hole Abandoned

Date

JUN 4 1947 19 S. J. LEWIS Scout