


Map No. **KANSAS** Sec. **20** Twp. **25** R. **14E**
 Well No. **1-Click** Farm _____
Shelby et al Company _____

NORTH

WEST

EAST

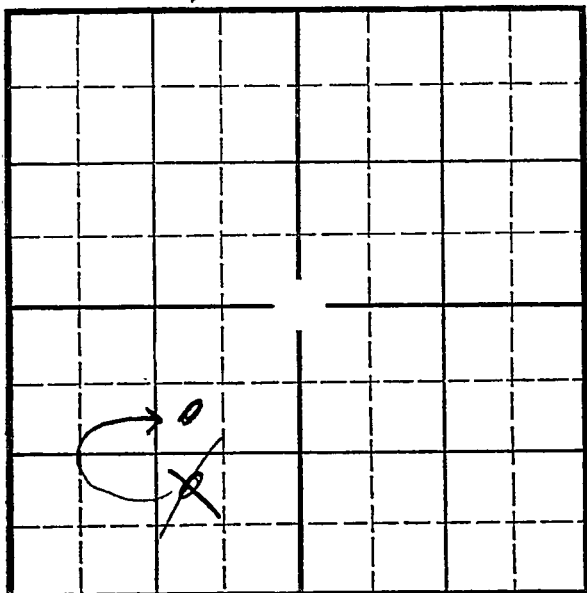

SOUTH

Location _____
 Drilling Remarks _____

Rig Up _____
 Drilling Remarks _____

RECORD

Cased _____ in. _____ ft.
 Sand _____
 Gas _____
 Oil _____
 Total Depth _____

PRODUCTION

1st 24 hrs. Nat. _____
 1st 24 hrs. after shot _____
 Gas _____ cu. ft. _____
 Dry Hole _____
 Abandoned _____

Woodson

Map No. KANSAS Sec. 20 Twp. 25 R. 14E

Well No. 1- Click Farm


Sheddy et al Company

990 Ft. from N. Line

~~990~~ Ft. from S. Line

990 Ft. from E. Line

_____ Ft. from W. Line

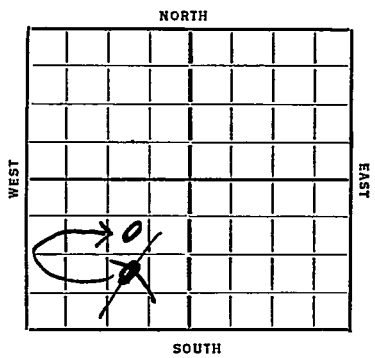

Date
1935
9/20
10/3
10/10
10/30

REPORT

Location
B S 1390-1400 Run 7"
Sand 1390-1400
T D 1450
170 Bbl.

COMPLETED

Map No. 17 Sec. 20 Twp. 25 R. 14EWell No. 1-ClickShedy et al Company

Contractor

FIRST REPORTS

SECTION PLAT

	0		

Ft. from N. Line

990 Ft. from S. Line990 Ft. from E. Line

Ft. from W. Line

Location ✓

Rig up

Drilling and Remarks:

RECORD

Cased.....in.,ft.

Sand.....

Gas.....

Oil.....

Total Depth.....

PRODUCTION

1st 24 hrs. Nat.....

1st 24 hrs. after shot.....

Gas.....Cu. Ft.

Dry Hole.....

Abandoned.....

Date

ORVAL MANNSCHRECK

9-20-35 192 Scout

KANSAS

Map No. 17 Sec. 20 Twp. 25 R. 14EWell No. 1-ClickShedy et al Company

Contractor

COMPLETED

SECTION PLAT

	10		

Ft. from N. Line

990 Ft. from S. Line990 Ft. from E. Line

Ft. from W. Line

Location

Rig up

Drilling and Remarks:

170 fbs

RECORD

Cased _____ in., _____ ft.

Sand 1390-1400

Gas _____

Oil _____

Total Depth 1450

PRODUCTION

1st 24 hrs. Nat. _____

1st 24 hrs. after shot _____

Gas _____ Cu. Ft.

Dry Hole _____

Abandoned _____

Date

10-30-35 192

CIVIL ENGINEER Scout

Map No. Sec. 20 Twp. 25 R. 14E

Well No. 1-Klick

Sheedy et al Company

..... Contractor

CORRECTION


SECTION PLAT

990 Ft. from N. Line

..... Ft. from S. Line

990 Ft. from E. Line

..... Ft. from W. Line

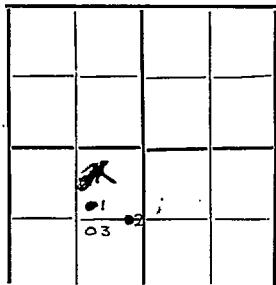

CORRECTION

CORRECTION

Location.....

Rig up.....

Drilling and Remarks:

Was incorrectly reported as being located in the NW SE SW.

OK located in SW NE

Date

RECORD

Cased.....in.,ft.

Sand **CORRECTION**

Gas.....

Oil.....

Total Depth.....

PRODUCTION

1st 24 hrs. Nat.....

1st 24 hrs. after shot.....

Gas.....Cu. Ft.

Dry Hole.....

Abandoned.....