


Woodson
25 R. 14E

Map No. KANSAS Sec. 20 Twp. 25 R. 14E

Well No. F. Klich Farm _____
Naco Oil Company _____

NORTH

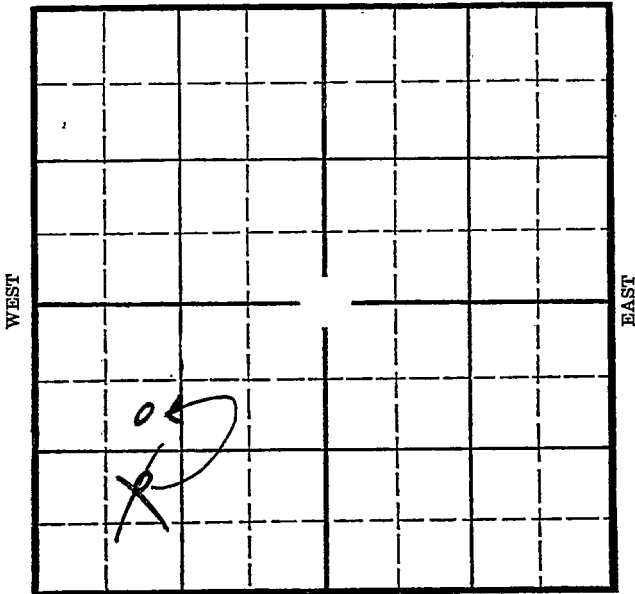

WEST

EAST

SOUTH

Location _____
Drilling Remarks _____

Rig Up _____
Drilling Remarks _____

RECORD

PRODUCTION

Cased _____ in. _____ ft.
Sand _____
Gas _____
Oil _____
Total Depth _____


1st 24 hrs. Nat. _____
1st 24 hrs. after shot _____
Gas _____ cu. ft. _____
Dry Hole _____
Abandoned _____

Woodson
25 R. 14E

Map No. KA 15A3 Sec. 20 Twp. 25 R. 14E

Well No. 2 Klick Farm
Acso Oil Company

990 Ft. from N. Line
~~990~~ Ft. from S. Line
Ft. from E. Line
990 Ft. from W. Line

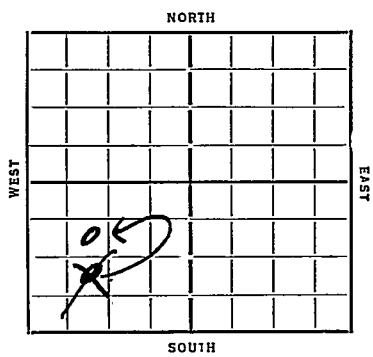

Date	REPORT
10/1/7	R W Mch.
11/1	dip 580 12" 110
11/17	50 TD 1396
11/14	6" 1370, B.S. 1383-1432
11/20	flowed 10 Bbls per hr.
	Sand 1383
	TD 1432
	200 Bbls.
	COMPLETED

Map No. 17 Sec. 20 Twp. 25 R. 14E

Well No. 2-Klick

Saco oil

Company

Contractor

SECTION PLAT

Ft. from N. Line

990

Ft. from S. Line

Ft. from E. Line

990

Ft. from W. Line

FIRST REPORT

Location

Rig up

Drilling and Remarks:

K. U. Machine

RECORD

Cased in., ft.

Sand

Gas

Oil

Total Depth

PRODUCTION

1st 24 hrs. Nat.

1st 24 hrs. after shot

Gas Cu. Ft.

Dry Hole

Abandoned

Date

10-17-35

Map No. 17 Sec. 20 Twp. 25 R. 14E

Well No. #2 Klick

Saco Company

Contractor

CORRECTION

SECTION PLAT

990 Ft. from N. Line

..... Ft. from S. Line

..... Ft. from E. Line

990 Ft. from W. Line

• 1	• 2		
	03		

CORRECTION

Location.....

Rig up.....

Drilling and Remarks:

This well was incorrectly reported as being located in the NE SW SW

RECORD

Cased..... in., ft.

Sand.....

Gas.....

Oil.....

Total Depth.....

PRODUCTION

1st 24 hrs. Nat.....

1st 24 hrs. after shot.....

Gas..... Cu. Ft.

Dry Hole.....

Abandoned.....

Date

FEB 19 1936

192

ORVAL MANNSCHRECK

Scout

Map No. 17 Sec. 20 Twp. 25 R. 14E

Well No. 2-Klick

Saco oil Company

Contractor

COMPLETE

SECTION PLAT

Ft. from N. Line

990 Ft. from S. Line

Ft. from E. Line

990 Ft. from W. Line

0			

Location.....

Rig up.....

Drilling and Remarks:

200 lbs

RECORD

Cased.....in.,ft.

Sand 1383

Gas.....

Oil.....

Total Depth 1432

PRODUCTION

1st 24 hrs. Nat.....

1st 24 hrs. after shot.....

Gas.....Cu. Ft.

Dry Hole.....

Abandoned.....

Date

ORVAL MANSCHRECK

11-20-35 192.....

Scout