


Map No. KANSAS Sec. 20 Twp. 25 R. 4E
 Well No. 3- Klichy Farm _____
Saco Oil Company _____

NORTH

WEST

EAST

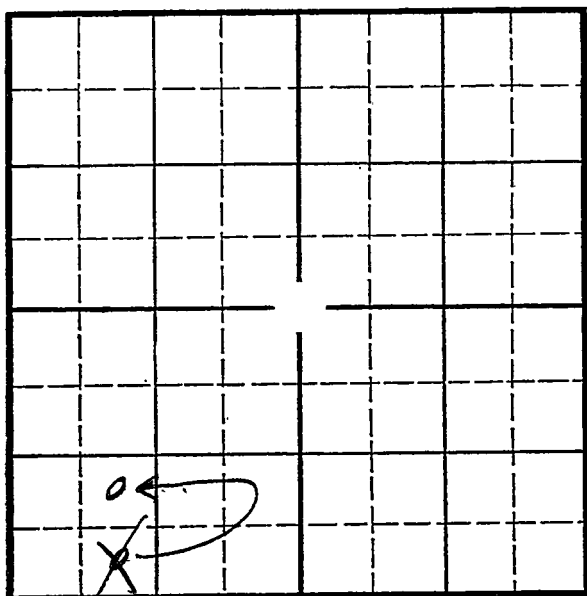

SOUTH

Location _____

Drilling Remarks _____

Rig Up _____

Drilling Remarks _____

RECORD

Cased _____ in. _____ ft.

Sand _____

Gas _____

Oil _____

Total Depth _____

PRODUCTION

1st 24 hrs. Nat. _____

1st 24 hrs. after shot _____

Gas _____ cu. ft. _____

Dry Hole _____

Abandoned _____

Woodson

KANSAS


Map No. _____ Sec. 20 Twp. 25 R. 14E
Well No. 3-1 Click Farm _____
Acro Oil Company _____

____ Ft. from N. Line

990 ~~990~~ Ft. from S. Line

990 Ft. from E. Line

990 Ft. from W. Line

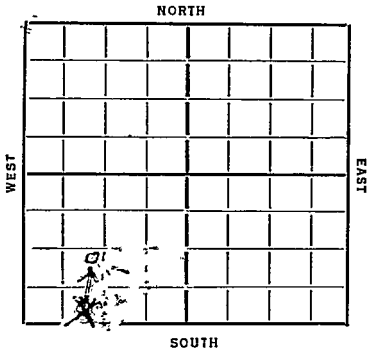

REPORT

1936
1/15 Spud
1/24 Oily 600
1/31 " 1190 8" 1110
2/7 6" 1365
Pay 14/20-24 1200' Oil 1429
90 gts @ 0
2/14 Spud
2/21 Drilling 100 Rbls per day
2/28 @ 0 Drilling
3/4 Land 1325
TD 1417
90 gts 125 Rbls.

COMPLETED


KANSAS

Map No. 17 Sec. 20 Twp. 25 R. 14 EWell No. 3 - KlickSaco Oil Company

Contractor

FIRST REPORTS

SECTION PLAT

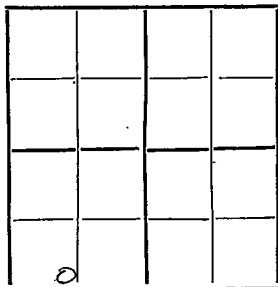

.....Ft. from N. Line

330 Ft. from S. Line

.....Ft. from E. Line

990 Ft. from W. Line

Location.....

Rig up.....

Drilling and Remarks:

Spud

RECORD

Cased.....in.,ft.

Sand.....

Gas.....

Oil.....

Total Depth.....

PRODUCTION

1st 24 hrs. Nat.....

1st 24 hrs. after shot.....

Gas.....Cu. Ft.

Dry Hole.....

Abandoned.....

Date

1-15-36 192.....

ORVAL MANNSCHRECK

Scout

Map No. 17 Sec. 20 Twp. 25 R. 14E

Well No. 3-Klick

Lico Oil Company

Contractor

CORRECTION

NE SW SW.

.....Ft. from N. Line

990 Ft. from S. Line

.....Ft. from E. Line

990 Ft. from W. Line

SECTION PLAT

0			

CORRECTION

Location.....

Rig up.....

Drilling and Remarks:

Incorrectly reported

as being in

SE SW SW

RECORD

Cased.....in.,ft.

Sand.....

Gas.....

Oil.....

Total Depth.....

PRODUCTION

1st 24 hrs. Nat.....

1st 24 hrs. after shot.....

Gas.....Cu. Ft.

Dry Hole.....

Abandoned.....

Date

FEB 5 1936

192

ORVAL MANNSCHRECK

Scout

Map No. 17 Sec. 20 Twp. 25 R. 14EWell No. 3- KlinkSaco oil Company

Contractor

COMPLETE

SECTION PLAT

CORRECTION

Ft. from N. Line

990 Ft. from S. Line

Ft. from E. Line

990 Ft. from W. Line

0			

Location

Rig up

Drilling and Remarks:

90 fts125 bbls

RECORD

Cased 1325 in., ft.

Sand

Gas

Oil

Total Depth 1417

PRODUCTION

1st 24 hrs. Nat.

1st 24 hrs. after shot

Gas Cu. Ft.

Dry Hole

Abandoned

CORRECTION

SPOT FROM SE-SW-SW TO
NESWSW ALSO FEET MEASUREMENTS

Date

ORVAL MANNSCHRECK

3-4-36 192 Scout