


Section 20 Township 25 Range 14-E

Well No. #6 Klick

Company Sacco

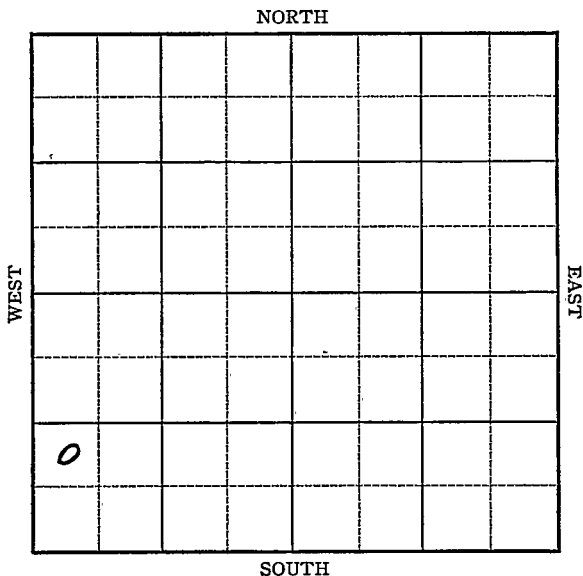

Sec. 20 Twp. 25 R. 14-E


Well No. #6 Klick Farm
Sacco Company

 Ft. from N. Line

990 Ft. from S. Line

 Ft. from E. Line

330 Ft. from W. Line

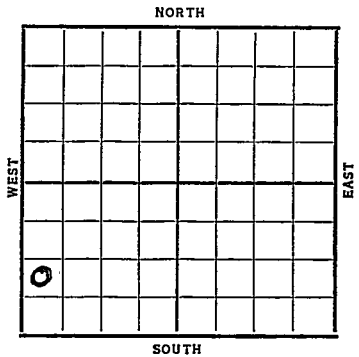

Date	REPORT
1937	
9/22	Mach.
10/2	"
10/6	6" @ 1385'.
	Bart. 1410'.
	T.D. 1450' S.W.
	P.B. 1425'.
	Shot 110 qts. 1400-25'.
	ABANDONED

*Woodson*Map No. 17 Sec. 20 Twp. 25 R. 14EWell No. 6 KlickSacco Company.

Contractor

FIRST REPORT

SECTION PLAT

0			

 Ft. from N. Line990 Ft. from S. Line Ft. from E. Line330 Ft. from W. LineLocation Rig up

Drilling and Remarks:

Wack

RECORD

Cased in., ft.Sand Gas Oil Total Depth

PRODUCTION

1st 24 hrs. Nat. 1st 24 hrs. after shot Gas Cu. Ft.Dry Hole Abandoned

Date

SEP 22 1937

19

H. D. Hatfield Scout

Woodson **KANSAS**

Map No. 17 Sec. 20 Twp. 25 R14E

Well No. 6 Klick

Sacco Company

Contractor

ABANDONED

NW SW SW

_____ Ft. from N. Line

990 Ft. from S. Line

_____ Ft. from E. Line

330 Ft. from W. Line

SECTION PLAT

0			

Location _____

Rig up _____

Drilling and Remarks:

P.B. 1425
Shot 110 gts
1400-25
DVA

RECORD

Cased 6 in., 1385 ft.

Sand Bart 1410

Gas _____

Oil _____

Total Depth 1450 SW

PRODUCTION

1st 24 hrs. Nat. _____

1st 24 hrs. after shot _____

Gas _____ Cu. Ft.

Dry Hole _____

Abandoned _____

Date

OCT - 6 1937 19

E. D. Hatfield Scout