

KANSAS


FORM 51 5M 1-42 PETROL

Butler

Section 23 Township 28 Range 7-E

Well No. #1 Brewer

Company Rex & Morris etal

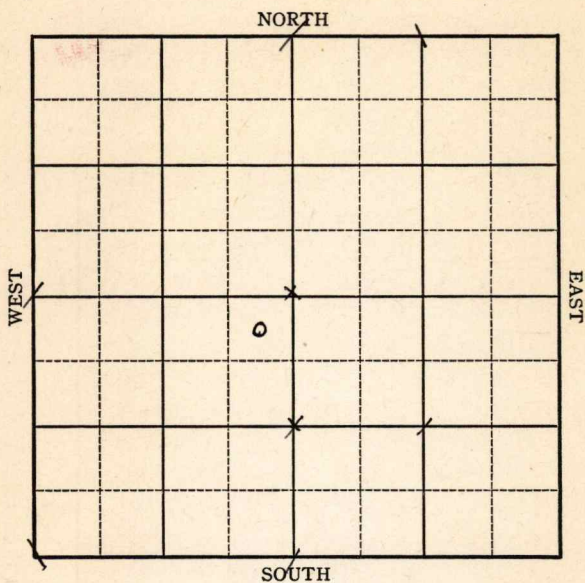

KANSAS

Butler

Sec. 23 Twp. 28 R. 7-E

Well No. #1 Brewer Farm


Rex & Morris etal Company

330 Ft. from N. Line

 Ft. from S. Line

330 Ft. from E. Line

 Ft. from W. Line

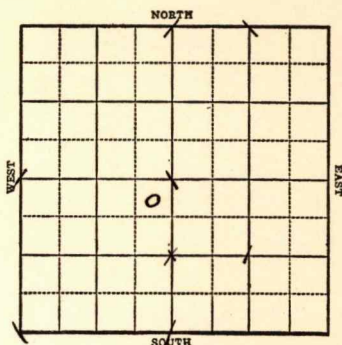

1943

R E P O R T

5/5 Machine

5/19 Drlg. 1340
8" @ 832'

5/25 Drlg. 1690
10" @ 1535

6/2 KC 2000
BKC 2115
Drlg. 2430

6/9 Miss 2745
T.D. 2767 SO
6" @ 2753 WOC.

6/16 Miss 2745
6" @ 2753'
T.D. 2767'
2000 gal acid
Pump 50 pot
Gravity 39.7

COMPLETED

KANSAS**Butler**Map No. 10 Sec. 23 Twp. 28 R. 7EWell No. 1 BrewerRex & Morris etal.


Company

FIRST REPORT

Contractor

NE SW

SECTION PLAT

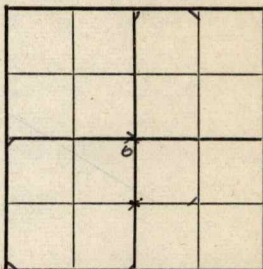330 Ft. from N. Line Ft. from S. Line330 Ft. from E. Line Ft. from W. Line

MISCELLANEOUS

Location Rig up

Drilling and Remarks:

Machine

RECORD

Cased in., ft.Sand Gas Oil Total Depth

PRODUCTION

1st 24 hrs. Nat. 1st 24 hrs. after shot Gas Cu. Ft.Dry Hole Abandoned

Date

MAY 5 1943 19S. J. LEWIS

Scout

KANSAS

Butler

Map No. 10 Sec. 23 Twp. 28 R. 7E

Well No. 1 Brewer

Rex & Morris et al. Company

COMPLETED Contractor

NE SW


SECTION PLAT

330 Ft. from N. Line

_____ Ft. from S. Line

330 Ft. from E. Line

_____ Ft. from W. Line

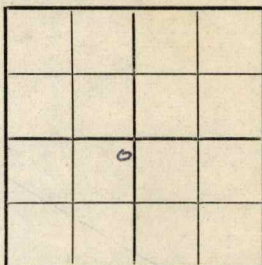

MISCELLANEOUS

Location _____

Rig up _____

Drilling and Remarks:

Miss 2745
6" @ 2753
2000 acs
Pump 50 Rk
39 2/3

RECORD

Cased _____ in., _____ ft.

Sand _____

Gas _____

Oil _____

Total Depth 2767

PRODUCTION

1st 24 hrs. Nat. _____

1st 24 hrs. after shot _____

Gas _____ Cu. Ft.

Dry Hole _____

Abandoned _____

Date

JUN 16 1943 19

S. J. LEWIS Scout