


-Sheedy et al Company

NORTH

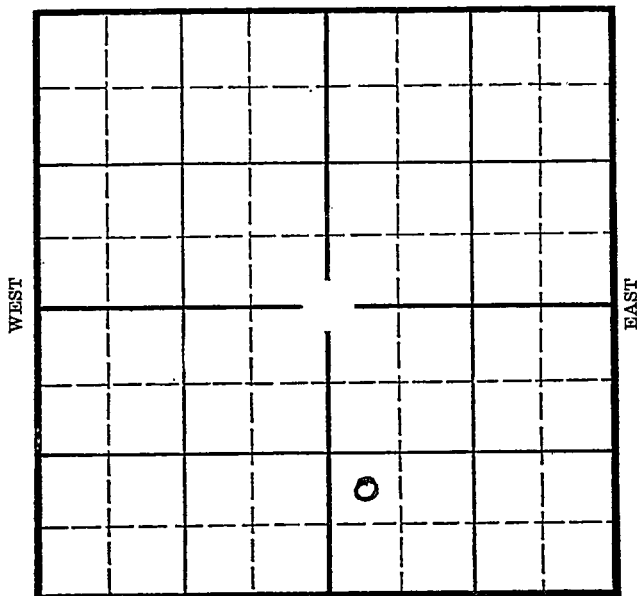

Location_____

Drilling Remarks

Rig Up

Drilling Remarks

RECORD

Cased_____in_____ft.

Sand

Gas

Oil_____

Total Depth_____

PRODUCTION

1st 24 hrs. Nat. _____

1st 24 hrs. after shot_____.

Gas_____cu. ft._____

Dry Hole_____


Abandoned_____

Ft. from N. Line

990 Ft. from S. Line

Ft. from E. Line

330 Ft. from W. Line

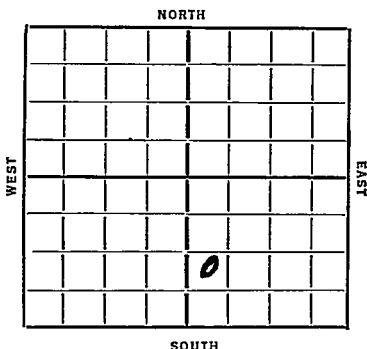

Date
1936

REPORT

4/8 Rigging up

4/16 Drlg. 350'

4/23 Drlg. 1000'

4/30 -- 5/7--

5/13/36- Sd. 1401-34'.

T.D. 1465'.

Shot 140 ats.

325 bbls.

COMPLETED

Map No. 17 Sec. 20 Twp. 25 R. 14EWell No. 5 HickSpeedy & Co. Company

Contractor

SECTION PLAT

Ft. from N. Line

980 Ft. from S. Line

Ft. from E. Line

330 Ft. from W. Line

FIRST REPORT

Location

Rig up

Drilling and Remarks:

Rigging up

RECORD

Cased.....in.,ft.

Sand.....

Gas.....

Oil.....

Total Depth.....

PRODUCTION

1st 24 hrs. Nat.....

1st 24 hrs. after shot.....

Gas.....Cu. Ft.

Dry Hole.....

Abandoned.....

Date

4/8/36

192

S. J. LEWIS

Scout

KANSASMap No. 17 Sec. 20 Twp. 25 R. 14EWell No. 5 KlickSheddy Company

Contractor

SECTION PLAT

		0	

_____ Ft. from N. Line

990 Ft. from S. Line

_____ Ft. from E. Line

330 Ft. from W. Line**COMPLETED**

Location _____

Rig up _____

Drilling and Remarks:

Sd 1401-34
Shot 1409 to
325 ft

RECORD

Cased _____ in., _____ ft.

Sand _____

Gas _____

Oil _____

Total Depth 1465**PRODUCTION**

1st 24 hrs. Nat. _____

1st 24 hrs. after shot _____

Gas _____ Cu. Ft.

Dry Hole _____

Abandoned _____

Date

MAY 13 1936

19

S. J. LEWIS

Scout