

KANSAS


FORM 51 5M PETROL

Butler

Section 23 Township 28 Range 7E

Well No. #3 Brewer

Company J.E. Morris & Wolf Creek

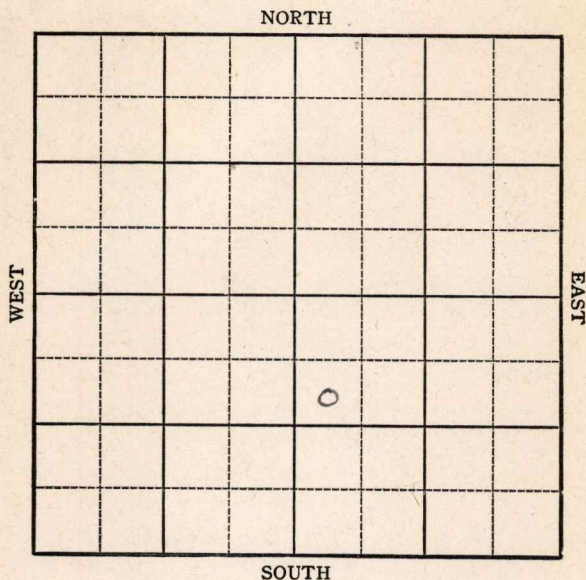

KANSAS

Butler

Sec. 23 Twp. 28 R. 7E

Well No. #3 Brewer Farm

J.E. Morris & Wolf Creek Company


Miscellaneous

990 Ft. from N. Line

 Ft. from S. Line

 Ft. from E. Line

330 Ft. from W. Line

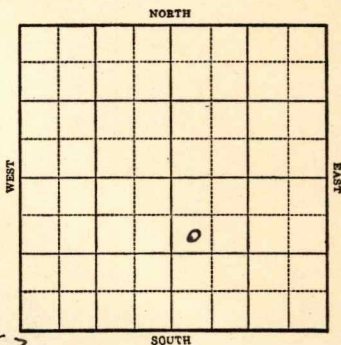

elev. 1452

1944

R E P O R T

2/16 Location
2/23 Cable Rig
3/1 Drlg. 265
3/8 10" @ 695 Drlg.
3/16 Lans 1630
Drilling 1700
3/22 KC 1955
8" @ 2125
Drlg. 2260'
3/29 7" @ 2705
5000 acid
TD 2729
Miss 2700
Pump 100 Pot
Gravity 40.6

COMPLETED

Map No. 10 Sec. 23 Twp. 28 R. 7E

Well No. 3 Brewer

J. E. Morris & Wolf Creek Company

FIRST REPORT

Contractor

SW NW SE

SECTION PLAT

990


Ft. from N. Line

Ft. from S. Line

Ft. from E. Line

330

Ft. from W. Line

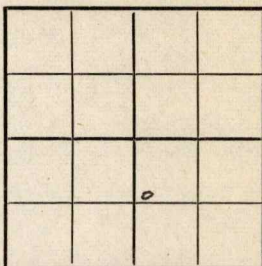

Miscellaneous

Location X

Rig up

Drilling and Remarks:

RECORD

Cased _____ in., _____ ft.

Sand _____

Gas _____

Oil _____

Total Depth _____

PRODUCTION

1st 24 hrs. Nat. _____

1st 24 hrs. after shot _____

Gas _____ Cu. Ft.

Dry Hole _____

Abandoned _____

Date

FEB 16 1944 19

S. J. LEWIS

Scout

KANSAS

Map No. 10 Sec. 23 Twp. 28 R. 7EWell No. 3 BrewerJ. E. Morris & Wolf Creek Company

COMPLETED

Contractor

SW NW SE

SECTION PLAT

990


Ft. from N. Line

Ft. from S. Line

Ft. from E. Line

330

Ft. from W. Line

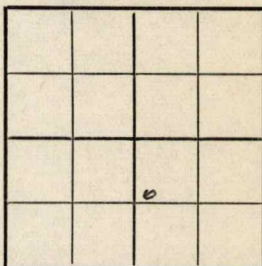

Miscellaneous

Location _____

Rig up _____

Drilling and Remarks:

*Miss 2700**7" @ 2705**5000 acid**Pump 100 Ps**40° - 81*

RECORD

Cased _____ in., _____ ft.

Sand _____

Gas _____

Oil _____

Total Depth 2729

PRODUCTION

1st 24 hrs. Nat. _____

1st 24 hrs. after shot _____

Gas _____ Cu. Ft.

Dry Hole _____

Abandoned _____

Date

MAR 29 1944 19

S. J. LEWIS Scout