


Section 23 Township 28 Range 7-E

Well No. #3 Ramp

Company Adair & Morton

NORTH Brandt Pool

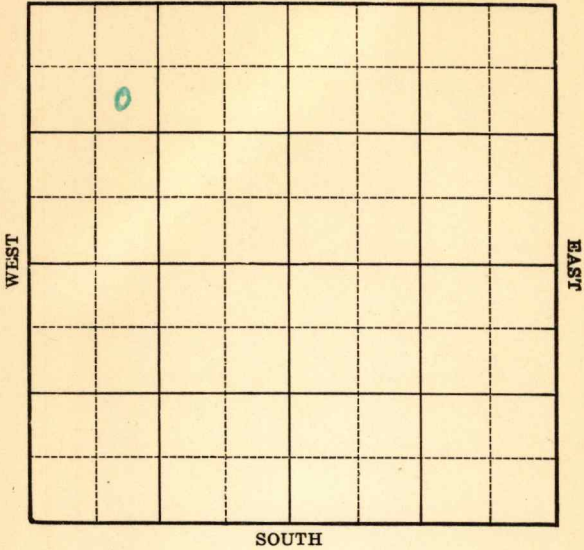

Sec. 23 Twp. 28 R. 7-E

Well No. #3 Ramp Farm _____

Adair & Morton Company


(Brandt)

990 Ft. from N. Line

_____ Ft. from S. Line

_____ Ft. from E. Line

990 Ft. from W. Line

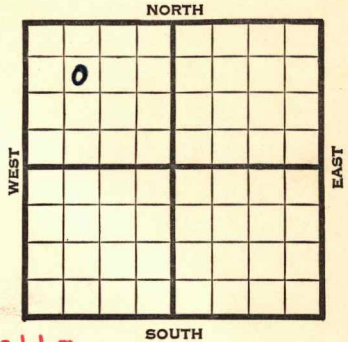

Elev. 1443

1941

REPORT

4/2

12" - 750'

Drlg. 1410'

4/10

10" - 1480' Drlg. 1750'

4/18

8" - 2110' Drlg. 2450'

4/24

Miss. 2705' 7" - 2705'

T.D. 2737' WOC.

4/30

Miss. 2705'

7" - 2705'

T.D. 2737'

3000 acid.

Potential 357 bbls., pump.

36. Gravity

COMPLETED

Map No. 10 Sec. 23 Twp. 28 R. 7E

Well No. 3 Ramp

Adair & Morton

Company

FIRST REPORT

Contractor

SE NW NW

990 Ft. from N. Line

_____ Ft. from S. Line

_____ Ft. from E. Line

990 Ft. from W. Line

SECTION PLAT

o			

BRANDT POOL

Location _____

Rig up _____

Drilling and Remarks:

12" - 750

Drlg. 1410

RECORD

Cased _____ in., _____ ft.

Sand _____

Gas _____

Oil _____

Total Depth _____

PRODUCTION

1st 24 hrs. Nat. _____

1st 24 hrs. after shot _____

Gas _____ Cu. Ft.

Dry Hole _____

Abandoned _____

Date

APR 2 1941 19

S. J. LEWIS Scout

Form 26—200 Bks.—1-40—Palace Butler

Map No. 10 Sec. 23 Twp. 28 R. 7E

Well No. 3 Ramp

Adair & Morton Company

COMPLETED Contractor

SECTION PLAT

SE NW NW

990 Ft. from N. Line

_____ Ft. from S. Line

_____ Ft. from E. Line

990 Ft. from W. Line

BRANDT POOL

Location _____

Rig up _____

Drilling and Remarks:

Miss 2705
7" C2705
3000 acid
Pump 357 Pst.

36° Gr

RECORD

Cased _____ in., _____ ft.

Sand _____

Gas _____

Oil _____

Total Depth 2297

PRODUCTION

1st 24 hrs. Nat. _____

1st 24 hrs. after shot _____

Gas _____ Cu. Ft.

Dry Hole _____

Abandoned _____

Date

APR 30 1941 19

S. J. LEWIS Scout