

KANSAS


Butler

FORM 51 5M PETROL

Section 23 Township 28 Range 7E

Well No. 4 Brewer

Company J. E. Morris etal

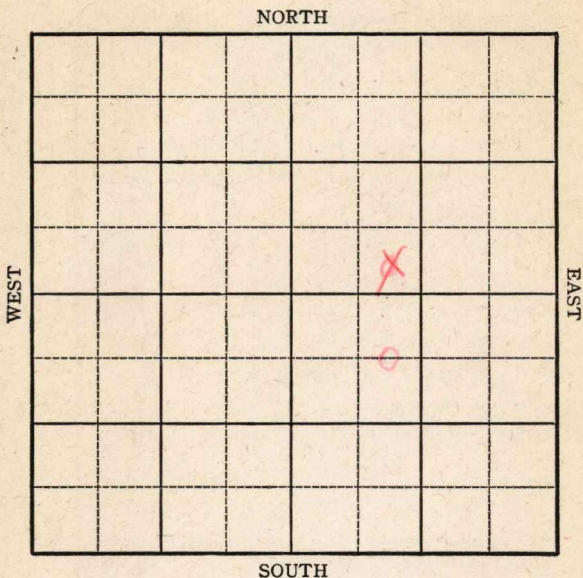

KANSAS Butler

Sec. 23 Twp. 28 R. 7-E


Well No. #4 Brewer Farm
J. E. Morris etal Company

660 Ft. from N. Line

70 Ft. from S. Line

_____ Ft. from E. Line

990 Ft. from W. Line

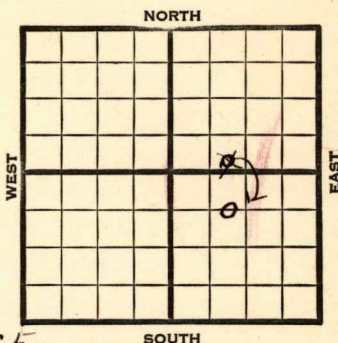

~~SE SW NE~~ C EL NW SE

1945

Elev. 1471

REPORT

7/18

Location

7/26

Drlg. 105

8/1

12" @ 760

Drlg. 1010

8/8

10" @ 1465

KC 1977

Drlg. 1985

8/15

Miss. 2725-2744

TD 2744

6" @ 2725 WOC

8/22

Miss. 2725

6" @ 2725

300 acid

TD 2744

Pump 100 Pot.

Grav. 38.0

COMPLETED

KANSASPool Name Miscellaneous
KansasMap No. 18 Sec. 23 Twp. 28 R. 7EWell No. 4 BrewerJ. E. Morris etal CompanyFIRST REPORT Contractor

SE SW NE

SECTION PLAT

Ft. from N. Line70 Ft. from S. LineFt. from E. Line990 Ft. from W. LineButler CountyLocation x

Rig up

Drilling and Remarks:

RECORD

Cased _____ in., _____ ft.

Sand _____

Gas _____

Oil _____

Total Depth _____

PRODUCTION

1st 24 hrs. Nat. _____

1st 24 hrs. after shot _____

Gas _____ Cu. Ft.

Dry Hole _____

Abandoned _____

Date

JUL 1 8 194519S. J. LEWIS

Scout

KANSAS

Kansas

Pool Name MiscellaneousMap No. 10 Sec. 23 Twp. 28 R. 7EWell No. 4 BrewerJ. E. Morris etal

Company

CORRECTION

Contractor


C E L N W S E

SECTION PLAT

660 Ft. from N. Line

Ft. from S. Line

Ft. from E. Line

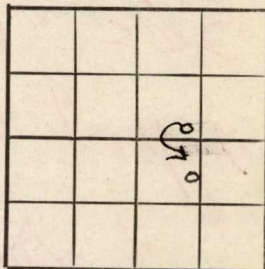990 Ft. from W. Line

Butler County

Location

Rig up

Drilling and Remarks:

*Was reported
SE BNWE*

RECORD

Cased _____ in., _____ ft.

Sand _____

Gas _____

Oil _____

Total Depth _____

PRODUCTION

1st 24 hrs. Nat. _____

1st 24 hrs. after shot _____

Gas _____ Cu. Ft.

Dry Hole _____

Abandoned _____

Date

AUG 1 1945

19

S. J. LEWIS

Scout

KANSAS

Kansas Pool Name MiscellaneousMap No. 10 Sec. 23 Twp. 28 R. 7EWell No. 4 BrewerJ.E. Morris etal Company**COMPLETED**

Contractor

C E L NW SE

E. 1/4
SECTION PLAT

		0	

660 Ft. from N. Line Ft. from S. Line Ft. from E. Line990 Ft. from W. LineButler CountyLocation Rig up

Drilling and Remarks:

Misc 2725
6" @ 2725
300 Acid
Pump 100 BT

*38°/hr***RECORD**Cased in., ft.Sand Gas Oil Total Depth 274.4**PRODUCTION**1st 24 hrs. Nat. 1st 24 hrs. after shot Gas Cu. Ft.Dry Hole Abandoned

Date

AUG 22 194519S. J. LEWIS Scout

What are you
correcting?

Sec Twp P-Kane
spot or what?
Sam

Misc. Small Maps

Cards

Tracing

France Map

Scarborough Map

Pierce Map

Geological Dept.

Pierce Flat Book