


Section 23 Township 28 Range 7E

Well No. #6 Brewer

Company J. E. Morris & CRA

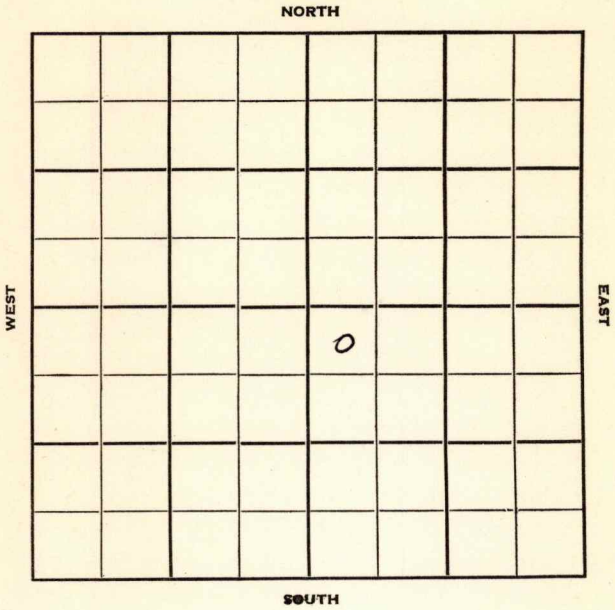

Butler

KANSAS ✓

Sec. 23 Twp. 28 R. 7 E

Well No. # 6 Brewer Farm

J. E. Morris & CRA Company

Rex & Morris Contractor


330 Ft. from N. Line

_____ Ft. from S. Line

_____ Ft. from E. Line

330 Ft. from W. Line

NW NW SE

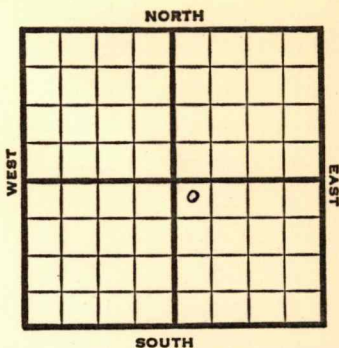

1951

Elev. 1440'

REPORT

5/16 Spud 5-13-51
Drlg. 350'

6/20 Spud 5-13-51 Oil well TD 2741'
Miss. 2704' 5" @ 2705' TD 2741'
2000 A
Comp. 30 BOPD

COMPLETED

