


KANSAS Butler County

Section 23 Township 28 Range 7E

Well No. #3 Lemon "B"

Company J. E. Morris et al

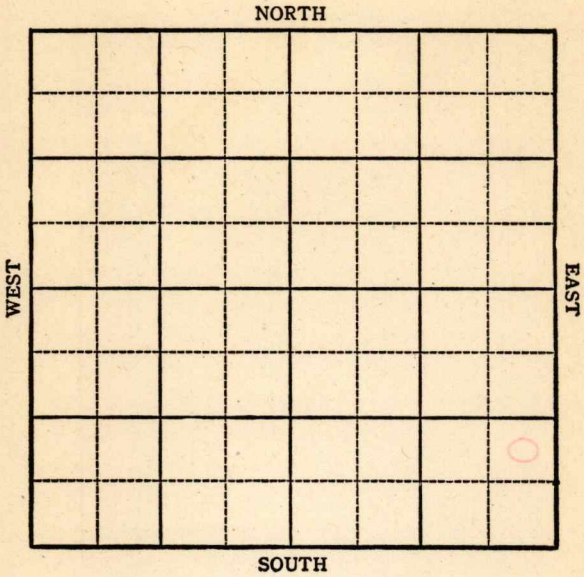

KANSAS

Butler County

Sec. 23 Twp. 28 R. 7E

Well No. #3 Lemon "B" Farm

J. E. Morris et al Company


Miscellaneous

_____ Ft. from N. Line

990 Ft. from S. Line

330 Ft. from E. Line

_____ Ft. from W. Line

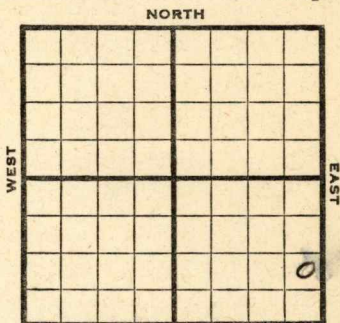

NE SE SE *8 Qu. 1472* SOUTH

1944

R E P O R T

11/15	Location	
11/24	Delg. 325	
12" @ 760	Drlg. 1310	11/29
12/6	10" @ 1595'	
	Drlg. 2005'	
12/14	Drlg. 2630'	
12/20	Miss	2729
	7" @ 2730	
	2000 acid	
	TD 2745	
	Pump 75 Pot	
	Grav. 40.0	

COMPLETED

Pool Name Miscellaneous

Map No. 10 Sec. 23 Twp. 28 R. 7E

Well No. 3 Lemon "B"

J. E. Morris etal Company

FIRST REPORT

Contractor

NE SE SE

SECTION PLAT

			0

_____ Ft. from N. Line

990 Ft. from S. Line

330 Ft. from E. Line

_____ Ft. from W. Line

Butler

Location X

Rig up _____

Drilling and Remarks:

RECORD

Cased _____ in., _____ ft.

Sand _____

Gas _____

Oil _____

Total Depth _____

PRODUCTION

1st 24 hrs. Nat. _____

1st 24 hrs. after shot _____

Gas _____ Cu. Ft.

Dry Hole _____

Abandoned _____

Date

NOV 15 1944 19

S. J. LEWIS Scout

