


Section 23 Township 28 Range 7-E

Well No. #2 Ramp

Company Adair & Morton

NORTH

Beaumont Pool

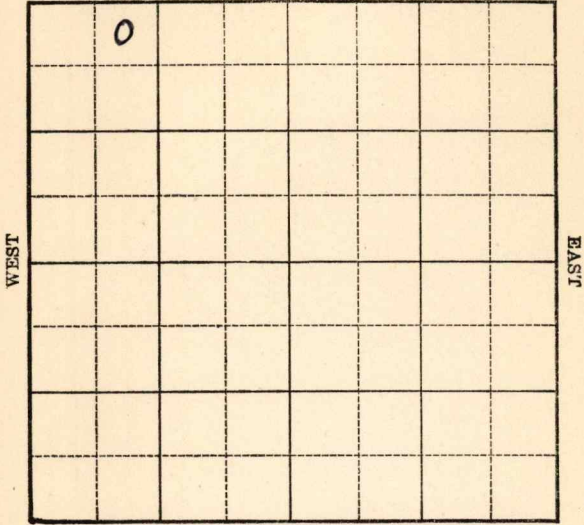

SOUTH

Sec. 23 Twp. 28 R. 7-E

Well No. #2 Ramp Farm _____

Adair & Morton Company


(Beaumont)

330 Ft. from N. Line

_____ Ft. from S. Line

_____ Ft. from E. Line

990 Ft. from W. Line

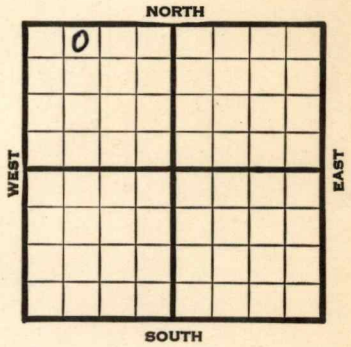

Elv. 1418

1939	REPORT
11/22	Cellar.
11/29	Machine.
12/7	Spud.
12/14	15" - 19' Drlg. 645'
12/21	10" - 1430' Drlg. 1645'
12/28	" " " "
1940	
1/4	" " " "
1/11	SD 1645'
1/18	Miss. 2668' 5" - 2673'
	T.D. 2691' WOC.
1/24	Miss. Lime 2668'
	5" - 2673'
	T.D. 2691'
	P.B. to 2678'
	2000 acid.
	40 bbls. oil.
	COMPLETED

Map No. 10 Sec. 23 Twp. 28 R. 7E

Well No. 2 Ramp

Adair & Morton Company

Contractor

FIRST REPORT
NE NW NW

SECTION PLAT

0			

330 Ft. from N. Line

_____ Ft. from S. Line

_____ Ft. from E. Line

990 Ft. from W. Line

BEAUMONT POOL

Location _____

Rig up _____

Drilling and Remarks:

Cellar

RECORD

Cased _____ in., _____ ft.

Sand _____

Gas _____

Oil _____

Total Depth _____

PRODUCTION

1st 24 hrs. Nat. _____

1st 24 hrs. after shot _____

Gas _____ Cu. Ft.

Dry Hole _____

Abandoned _____

Date

NOV 22 1939 19

S. J. LEWIS

Scout

Map No. 10 Sec. 23 Twp. 28 R. 7E

Well No. 2 Ramp

Adair & Morton Company

Contractor

COMPLETED
NE NW NW

SECTION PLAT

330 Ft. from N. Line

_____ Ft. from S. Line

_____ Ft. from E. Line

990 Ft. from W. Line

o			

BEAUMONT POOL

Location _____

RECORD

Rig up _____

Cased _____ in., _____ ft.

Drilling and Remarks:

Sand _____

Gas _____

Oil _____

Total Depth 2691

Miss. Lim. 2668

5" @ 2673

P.B. 2678.

2000 acid

40 8 1/2

PRODUCTION

1st 24 hrs. Nat. _____

1st 24 hrs. after shot _____

Gas _____ Cu. Ft.

Dry Hole _____

Abandoned _____

Date

JAN 24 1940 19

S. J. LEWIS

Scout