


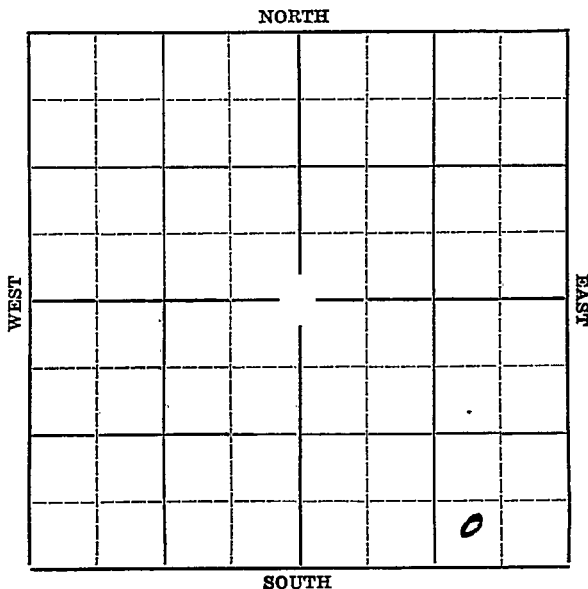

Section 20 Township 25 Range 14-E

Well Number 7-Klick

Company Sheedy



Map No. **KANSAS** Sec. **20** Twp. **25** R. **14E**

Well No. **#7 Klick** Farm


Sheddy Company

_____ Ft. from N. Line

330' Ft. from S. Line

990' Ft. from E. Line

_____ Ft. from W. Line

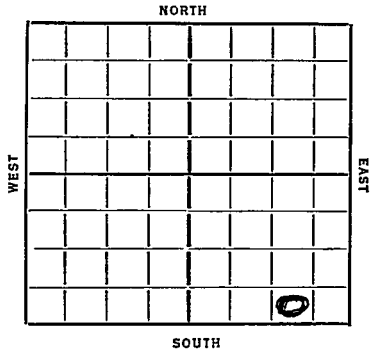

Date **1936** REPORT

6/10 Rigging up.

6/18 Drlg. 630'.

6/25 Drlg. 1400'.

7/2 No report.

7/9 Shut down.

7/15/36-Bart. sand 1406'.

T.D. 1465'.

Shot 300 qts.

725 bbls of oil flowing.

COMPLETED

Map No. 17 Sec. 20 Twp. 25 R. 14E

Well No. 7 Klick

Sheedy Company
Contractor

SECTION PLAT

			0

_____ Ft. from N. Line

930 Ft. from S. Line

990 Ft. from E. Line

_____ Ft. from W. Line

FIRST REPORT

Location _____

Rig up _____

Drilling and Remarks:

Rigging up

RECORD

Cased _____ in., _____ ft.

Sand _____

Gas _____

Oil _____

Total Depth _____

PRODUCTION

1st 24 hrs. Nat. _____

1st 24 hrs. after shot _____

Gas _____ Cu. Ft.

Dry Hole _____

Abandoned _____

Date

JUN 10 1936

Map No. 17 Sec. 20 Twp. 25 R. 14E

Well No. 7 Kicks

Sheddy Company
Contractor

SECTION PLAT

			0

_____ Ft. from N. Line
330 Ft. from S. Line
990 Ft. from E. Line
_____ Ft. from W. Line

COMPLETED

Location _____

Rig up _____

Drilling and Remarks:

Part. Col. 1406
Shot 300g to
725 ft of flowing

RECORD

Cased _____ in., _____ ft.
Sand _____
Gas _____
Oil _____
Total Depth 1465

PRODUCTION

1st 24 hrs. Nat. _____
1st 24 hrs. after shot _____
Gas _____ Cu. Ft.
Dry Hole _____
Abandoned _____

Date

JUL 15 1936 19

S. J. LEWIS Scout