

KANSAS


FORM 51 5M 1-42 PETROL

Butler

Section 23 Township 28 Range 7-E

Well No. #1 Seeley

Company Rex & Morris

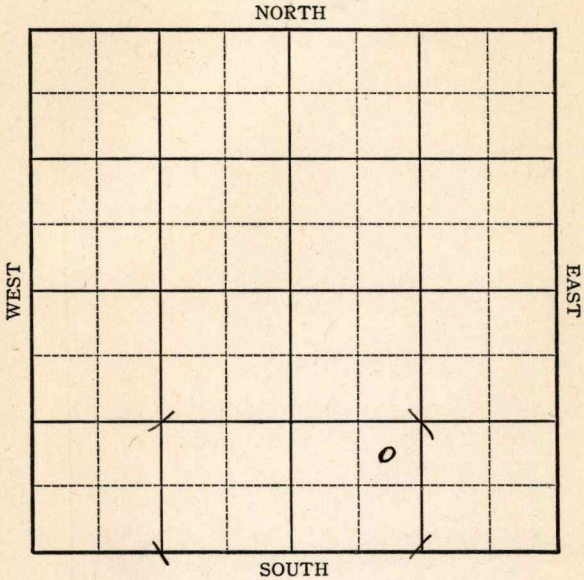

KANSAS

Butler


Sec. 23 Twp. 28 R. 7-E

Well No. #1 Seeley Farm

Rex & Morris

Company

NORTH

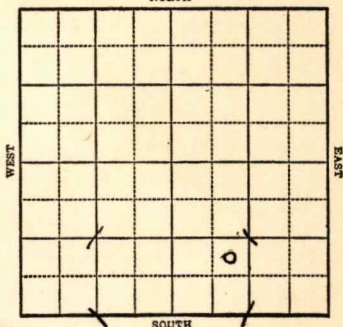

 Ft. from N. Line

990 Ft. from S. Line

 Ft. from E. Line

990 Ft. from W. Line

Miscellaneous

1943 *Elev. 1477* R E P O R T

7/28 Machine

8/4 Drlg. 500'

8/11 Drlg. 1210'
12₂ @ 835"

8/18 10" @ 1445
Lans 1660
KC 1985
Drlg. 2010'

8/25 8" @ 2190'
Drlg. 2560'

9/1 *Miss 2731*
7" @ 2731
T.D. 2949-500' oil 2 hrs
3000 acid

9/8 *Miss 2731*
7" @ 2731
3000 acid
Pump 50 Pot.
T.D. 2752

COMPLETED

KANSAS
Map No. 10 Sec. 23 Twp. 28 R. 7E

Well No. 1 Seeley

Rex & Morris Company

COMPLETED Contractor

NE SW SE

Ft. from N. Line


990 Ft. from S. Line

Ft. from E. Line

990 Ft. from W. Line

MISCELLANEOUS

SECTION PLAT

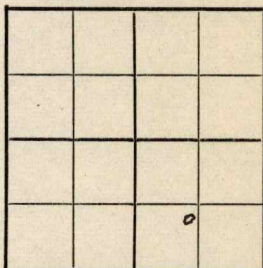

Location _____

Rig up _____

Drilling and Remarks:

Miss 2731

7" @ 2731

3000 and

Pump 50 Bt

RECORD

Cased _____ in., _____ ft.

Sand _____

Gas _____

Oil _____

Total Depth 2752

PRODUCTION

1st 24 hrs. Nat. _____

1st 24 hrs. after shot _____

Gas _____ Cu. Ft.

Dry Hole _____

Abandoned _____

Date

SEP 8 1943 19


S. J. LEWIS Scout

Butler

KANSASMap No. 10 Sec. 23 Twp. 28 R. 7EWell No. 1 SeeleyRex & Morris CompanyFIRST REPORT Contractor

NE SW SE

SECTION PLAT

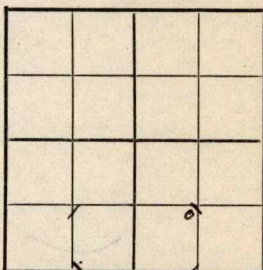 Ft. from N. Line990 Ft. from S. Line Ft. from E. Line990 Ft. from W. Line

MISCELLANEOUS

Location Rig up

Drilling and Remarks:

Machine

RECORD

Cased in., ft.Sand Gas Oil Total Depth

PRODUCTION

1st 24 hrs. Nat. 1st 24 hrs. after shot Gas Cu. Ft.Dry Hole Abandoned

Date

JUL 28 1943 19S. J. LEWIS Scout