


Section 23 Township 28 Range 7E

Well No. 2 Seeley

Company J.E.Morris & Wolf Creek

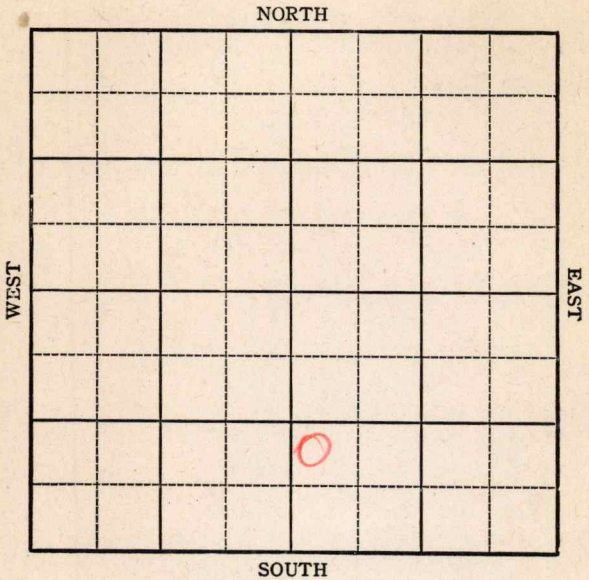

**KANSAS**

Butler

Sec. 23 Twp. 28 R. 7E

Well No. 2 Seeley Farm

J. E. Morris & Wolf Creek Company

Miscellaneous


Ft. from N. Line

850 Ft. from S. Line

850 Ft. from E. Line

190 Ft. from W. Line

NW SW SE

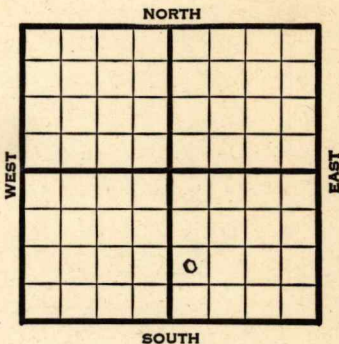

1945 **Elev. 1490** REPORT

- 6/13 Machine
- 6/21 Drlg. 495
- 6/28 Drlg. 1430
- 7/3 10" @ 1495  
**KC 1985**
- 7/11 Drlg. 2160  
**Miss. 2731**  
5" @ 2732  
Drlg. 2775'
- 7/18 **Arb. 3152**  
TD 3202'

**ABANDONED**

Pool Name Miscellaneous

Map No. 10 Sec. 23 Twp. 28 R. 7E

Well No. 2 Seeley

J. E. Morris & Wolf Creek Company

**FIRST REPORT**

Contractor

NW SW SE

**SECTION PLAT**

\_\_\_\_\_ Ft. from N. Line

850 Ft. from S. Line

\_\_\_\_\_ Ft. from E. Line

190 Ft. from W. Line

		o	

Butler County

Location \_\_\_\_\_

Rig up \_\_\_\_\_

Drilling and Remarks:

machine

**RECORD**

Cased \_\_\_\_\_ in., \_\_\_\_\_ ft.

Sand \_\_\_\_\_

Gas \_\_\_\_\_

Oil \_\_\_\_\_

Total Depth \_\_\_\_\_

**PRODUCTION**

1st 24 hrs. Nat. \_\_\_\_\_

1st 24 hrs. after shot \_\_\_\_\_

Gas \_\_\_\_\_ Cu. Ft.

Dry Hole \_\_\_\_\_

Abandoned \_\_\_\_\_

Date

JUN 13 1945 19

S. J. LEWIS

Scout

