

KANSAS


Butler

FORM 51 5M PETROL

Section 24 Township 28 Range 7E

Well No. 2 Varner

Company J. E. Morris etal

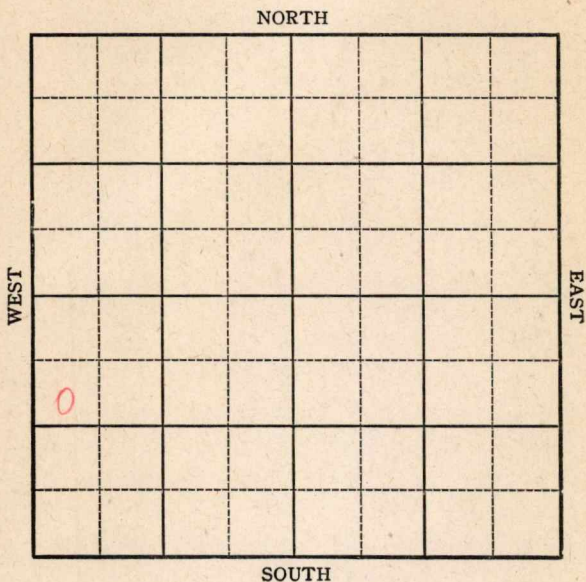

KANSAS

Butler County

Sec. 24 Twp. 28 R. 7E

Well No. 2 Varner Farm

J. E. Morris etal Company


Miscellaneous

Ft. from N. Line

1420 Ft. from S. Line

Ft. from E. Line

330 Ft. from W. Line

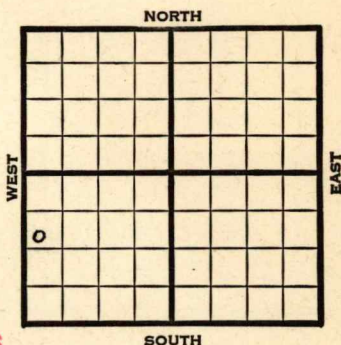

SW NW SW Elev. 1436

1945

REPORT


5/2 Machine  
5/10 "  
5/17 30' S.D.  
5/24 Drlg. 120'  
5/31 Drlg. 540  
6/8 10" @ 710 Drlg.  
6/14 Drlg. 960  
6/21 1495 UR 8"  
6/28 " "  
7/3 8" @ 1560  
Lans 1624  
Drlg. 1780'  
7/11 Drlg. 1955  
7/19 KC 1960  
6" @ 2065  
Drlg. 2185  
7/25 Miss. 2701  
5" @ 2705  
TD 2743

ABANDONED

Kansas Pool Name MiscellaneousMap No. 10 Sec. 24 Twp. 28 R. 7EWell No. 2 VarnerJ. E. Morris etal CompanyFIRST REPORT Contractor

SW NW SW

## SECTION PLAT

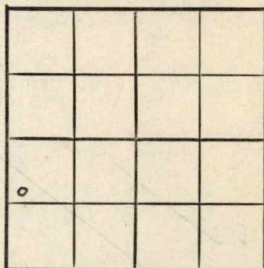Ft. from N. Line1420 Ft. from S. LineFt. from E. Line330 Ft. from W. Line

Butler County

Location \_\_\_\_\_

Rig up \_\_\_\_\_

Drilling and Remarks:  
machine

## RECORD

Cased \_\_\_\_\_ in., \_\_\_\_\_ ft.

Sand \_\_\_\_\_

Gas \_\_\_\_\_

Oil \_\_\_\_\_

Total Depth \_\_\_\_\_

## PRODUCTION

1st 24 hrs. Nat. \_\_\_\_\_

1st 24 hrs. after shot \_\_\_\_\_

Gas \_\_\_\_\_ Cu. Ft.

Dry Hole \_\_\_\_\_

Abandoned \_\_\_\_\_

Date

MAY 2 1945 19 S. J. LEWIS Scout

**KANSAS** Kansas Pool Name Miscellaneous

Map No. 10 Sec. 24 Twp. 28 R. 7E

Well No. 2 Varner

J. E. Morris etal Company

**ABANDONED**

Contractor

SW NW SW

*E 1/4 86*

**SECTION PLAT**

|  |  |  |  |
|--|--|--|--|
|  |  |  |  |
|  |  |  |  |
|  |  |  |  |
|  |  |  |  |

       Ft. from N. Line

1420 Ft. from S. Line

       Ft. from E. Line

330 Ft. from W. Line

Butler County

Location                                 

Rig up                                 

Drilling and Remarks:

*Miss 2701*

*5" @ 2705*

**RECORD**

Cased            in.,            ft.

Sand                                 

Gas                                 

Oil                                 

Total Depth 2743

**PRODUCTION**

1st 24 hrs. Nat.                                 

1st 24 hrs. after shot                                 

Gas                                  Cu. Ft.

Dry Hole                                 

Abandoned                                 

Date

JUL 25 1945 19

S. J. LEWIS

Scout