


Section 20 Township 25 Range 14-E

Well No. 8 Klick

Company Saco

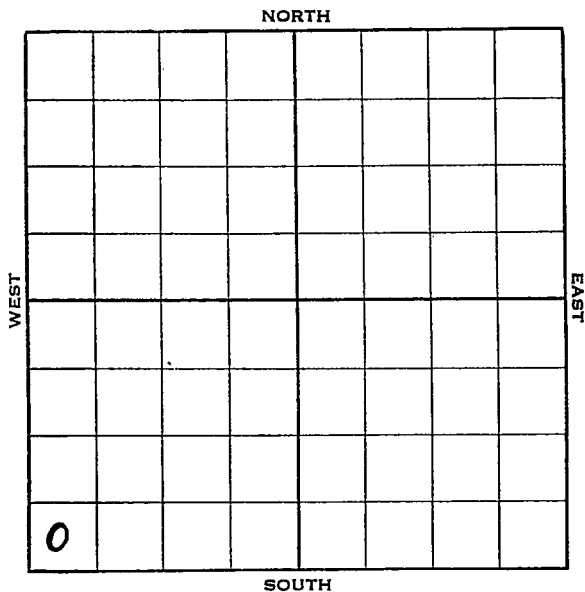

Sec. 20 Twp. 25 R. 14-E


Well No. #8 Klick Farm _____
Saco Company _____

_____ Ft. from N. Line

330 Ft. from S. Line

_____ Ft. from E. Line

330 Ft. from W. Line

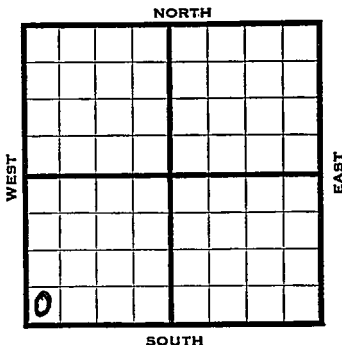

1938	REPORT
4/6	Location
4/15	"
4/22	Mach.
4/29	12" @ 75'. Drlg. 400'.
5/6	10" @ 590'. Bart. 1399'.
	T.D. 1428'. 600' oil.
	Shot 120 qts. Cleaning out.
5/12	6" @ 1392'.
5/20	P.B. 1425'.
5/25	6" @ 1392'.
	Bart. 1399'.
	T.D. 1428'.
	P.B. 1425'.
	Est. 30 bbls.
	COMPLETED

Map No. 17 Sec. 20 Twp. 25 R. 14E

Well No. 8 Klick

Saco

Company

FIRST REPORT

Contractor

SW/C

SECTION PLAT

_____ Ft. from N. Line

330 Ft. from S. Line

_____ Ft. from E. Line

330 Ft. from W. Line

Location X

RECORD

Rig up _____

Cased _____ in., _____ ft.

Drilling and Remarks:

Sand _____

Gas _____

Oil _____

Total Depth _____

PRODUCTION

1st 24 hrs. Nat. _____

1st 24 hrs. after shot _____

Gas _____ Cu. Ft.

Dry Hole _____

Abandoned _____

Date

APR 6 - 1938

19

H. D. Hatfield

Scout

Woodson KANSAS

Map No. 17 Sec. 20 Twp. 25 R. 14EWell No. 8 KlickSaco

Company

Contractor

COMPLETED**SW/C**

_____ Ft. from N. Line

330 Ft. from S. Line

_____ Ft. from E. Line

330 Ft. from W. Line**SECTION PLAT**

0			

Location _____

Rig up _____

Drilling and Remarks:

P.B. 1425EST 30 bbl**RECORD**Cased 6 in. 1392 ft.Sand BART 1399

Gas _____

Oil _____

Total Depth 1428**PRODUCTION**

1st 24 hrs. Nat. _____

1st 24 hrs. after shot _____

Gas _____ Cu. Ft.

Dry Hole _____

Abandoned _____

Date

MAY 25 1938 19H. D. Hatfield Scout