


Section 23 Township 28 Range 7E

Well No. 3 Sealy

Company Rex & Morris

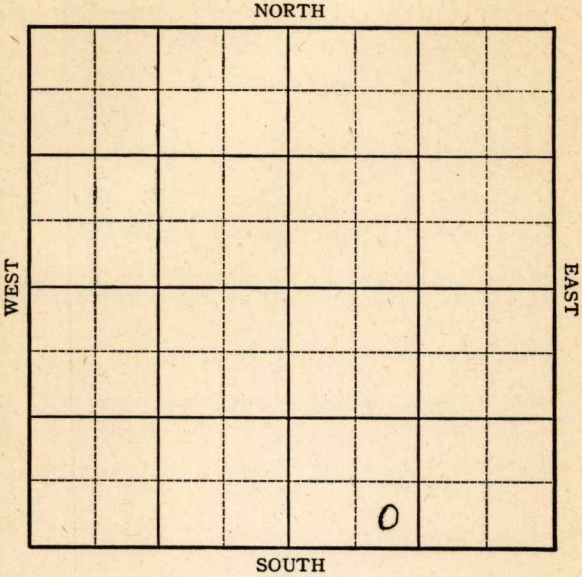

Sec. 23 Twp. 28 R. 7E

Well No. #3 Sealy Farm _____

Rex & Morris Company


Misc.

_____ Ft. from N. Line

330 Ft. from S. Line

_____ Ft. from E. Line

990 Ft. from W. Line

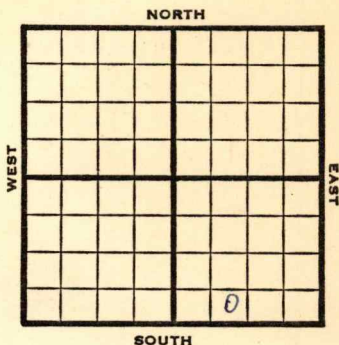

SE SW SE

1946 **Elev 1478'** REPORT

5/15 Drlg. 380'

5/21 Drlg 1260'

5/29 12" @ 780

10" @ 150

Drlg. 1810'

6/5 **KC 1990**

8" @2180

Drlg. 2640

6/12 **Miss 2730**

7" @ 2729'

2000 acid

Pump 50 Pot

40.0 Gr.

TD 2753'

COMPLETED

Kansas Pool Name Misc.

Map No. 10 Sec. 23 Twp. 28 R. 7E

Well No. 3 Sealy

Rex & Morris Company

FIRST REPORT Contractor

SE SW SE

SECTION PLAT

_____ Ft. from N. Line

330 Ft. from S. Line

_____ Ft. from E. Line

990 Ft. from W. Line

Butler County

Location _____

Rig up _____

Drilling and Remarks:

Dr 19380

RECORD

Cased _____ in., _____ ft.

Sand _____

Gas _____

Oil _____

Total Depth _____

PRODUCTION

1st 24 hrs. Nat. _____

1st 24 hrs. after shot _____

Gas _____ Cu. Ft.

Dry Hole _____

Abandoned _____

Date

MAY 15 1946 19

S. J. LEWIS Scout

KANSAS Kansas Pool Name Miscellaneous

Map No. 10 Sec. 23 Twp. 28 R. 7E

Well No. 3 Sealy

Rex & Morris Company

COMPLETED Contractor

SE SW SE

E 1,1478
SECTION PLAT

_____ Ft. from N. Line

330 Ft. from S. Line

_____ Ft. from E. Line

990 Ft. from W. Line

			0

Butler County

Location _____

Rig up _____

Drilling and Remarks:

*Miss 2730
7" c 2729

RECORD

Cased _____ in., _____ ft.

Sand _____

Gas _____

Oil _____

Total Depth 2753

PRODUCTION

1st 24 hrs. Nat. _____

1st 24 hrs. after shot _____

Gas _____ Cu. Ft.

Dry Hole _____

Abandoned _____

Date

JUN 12 1946 19

S. J. LEWIS Scout