

KANSAS


FORM 51 5M PETROL

Butler

Section 25 Township 28 Range 7E

Well No. #1 Wright

Company J.E. Morris & Wolf Creek

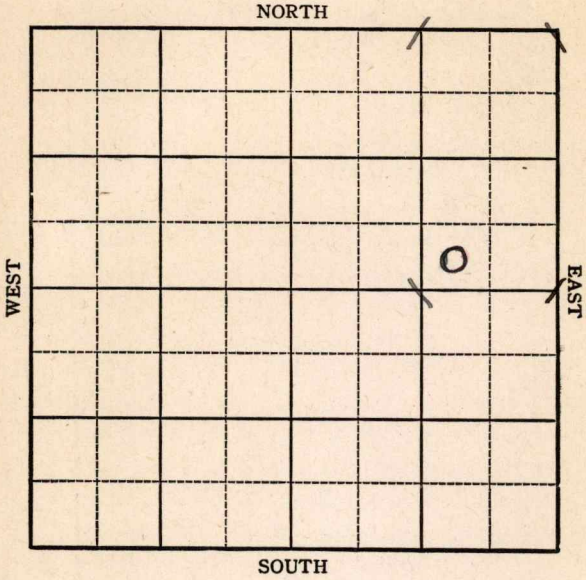

Sec. 25 Twp. 28 R. 7E

Well No. #1 Wright Farm

J.E. Morris & Wolf Creek Company


Miscellaneous

_____ Ft. from N. Line

330 Ft. from S. Line

990 Ft. from E. Line

_____ Ft. from W. Line

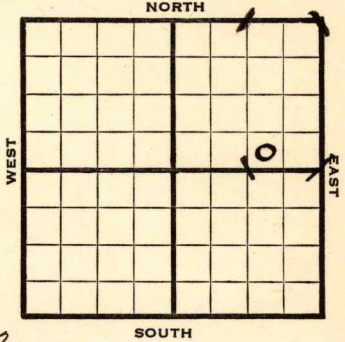

Elev. 1493

1944

REPORT

- 3/2 2 Cellar
- 3/29 "
- 4/5 Drlg. 240
- 4/12 12" @ 875
Drlg 1245
- 4 /19 10" @ 1505
Lans 1665
Drlg. 1770
- 4/26 8" @ 1920
KC 1729
Drlg. 1875
- 5/3 **BKC 2165**
Miss 2770
6" @ 2722
TD 2780 100' oil 1 hr.
- 5/10 " "
- 5/17 **Miss. 2770**
6" - 2772
2000 acid
Pot. - Pump 75
Gravity 36.4
Total Depth 2780

COMPLETED

KANSAS

Map No. 10 Sec. 25 Twp. 28 R. 7E

Well No. 1 Wright


J.E. Morris & Wolf Creek Company

FIRST REPORT

Contractor

SW SE NE

SECTION PLAT

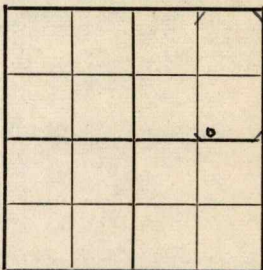

_____ Ft. from N. Line

330 Ft. from S. Line

990 Ft. from E. Line

_____ Ft. from W. Line

Miscellaneous

Location _____

Rig up _____

Drilling and Remarks:

Cellar

RECORD

Cased _____ in., _____ ft.

Sand _____

Gas _____

Oil _____

Total Depth _____

PRODUCTION

1st 24 hrs. Nat. _____

1st 24 hrs. after shot _____

Gas _____ Cu. Ft.

Dry Hole _____

Abandoned _____

Date

MAR 22 1944

19

S. J. LEWIS Scout