


Woodson

KANSAS

Section 20 Township 25 Range 14-E

Well No. 12 Klick

Company Sheedy et al

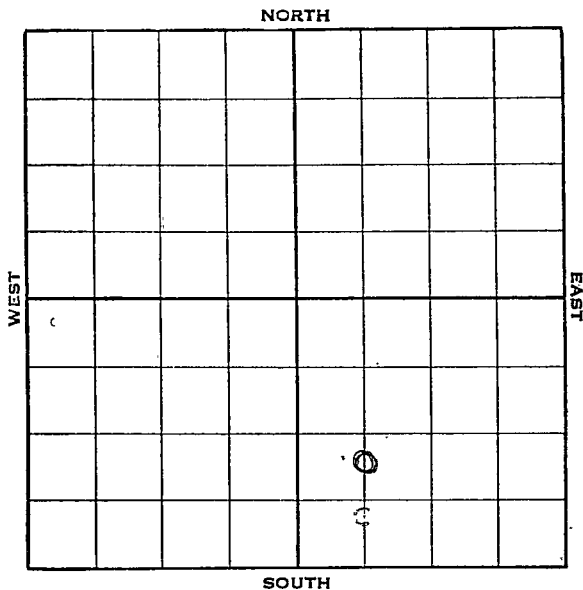

Sec. 20 Twp. 25 R. 14-E

Well No. #12 Klick Farm


Sheedy et al Company

           Ft. from N. Line

990 Ft. from S. Line

           Ft. from E. Line

660 Ft. from W. Line

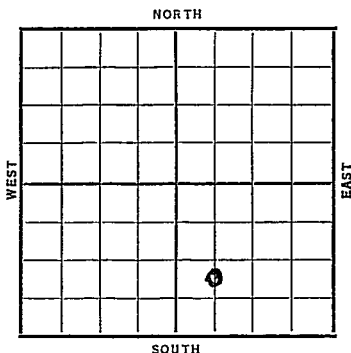

Date	REPORT
1938	
2/9	R..U. M.
2/18	Drlg. 500'.
2/26	" "
3/4	6" @ 1400'. Bart. 1405-35'. T.D. 1453'. 300' oil in 6 hrs.
3/11	Shot 170 qts. Cleaning out.
3/18	" " " " "
3/23	6" @ 1400'.
	Bart. 1405'.
	T.D. 1453'.
	Shot 170 qts.
	Flow 40 bbls.
	<b>COMPLETED</b>

Map No. 17 Sec. 20 Twp. 25 R. 14EWell No. 12 KlickSheedy etal Company

Contractor

**FIRST REPORT**

C N L SW SE

**SECTION PLAT**         Ft. from N. Line990 Ft. from S. Line         Ft. from E. Line660 Ft. from W. Line

		0	

Location                                 **RECORD**Cased          in.,          ft.Sand                                 Gas                                 Oil                                 Total Depth                         Rig up                                 

Drilling and Remarks:

**R. U. M.****PRODUCTION**1st 24 hrs. Nat.                         1st 24 hrs. after shot                         Gas                                  Cu. Ft.Dry Hole                                 Abandoned                                 

Date

FEB 9 1938 19          H. D. Hatfield Scout

Woodson

KANSAS

Map No. 17 Sec. 20 Twp. 25 R. 14EWell No. 12 KlickSheedy et al

Company

Contractor

**COMPLETED**

C N L SW SE

\_\_\_\_\_ Ft. from N. Line

990 Ft. from S. Line

\_\_\_\_\_ Ft. from E. Line

660 Ft. from W. Line**SECTION PLAT**

		0	

Location \_\_\_\_\_

Rig up \_\_\_\_\_

Drilling and Remarks:

Shot 170 gals40 bblsFlow**RECORD**Cased 6 in., 1400 ft.Sand BART 1405

Gas \_\_\_\_\_

Oil \_\_\_\_\_

Total Depth 1453**PRODUCTION**

1st 24 hrs. Nat. \_\_\_\_\_

1st 24 hrs. after shot \_\_\_\_\_

Gas \_\_\_\_\_ Cu. Ft.

Dry Hole \_\_\_\_\_

Abandoned \_\_\_\_\_

Date

MAR 23 1938

19

H. D. Hatfield

Scout